

Give All Information Completely
Make Required Affidavit
Mail or Deliver Report to:
Conservation Division
State Corporation Commission
211 No. Broadway
Wichita, Kansas

WELL PLUGGING RECORD

Pawnee County, Sec. 4 Twp. 23 Rge. (E) 17(W)

Location as "NE/CNW/SW" or footage from lines 0 W/2 NE NE

Lease Owner Clark Knight Drilling Company

Lease Name Ewing Well No. 4

Office Address 2433 Walnut Drive, Great Bend, Kansas

Character of Well (completed as Oil, Gas or Dry Hole) oil

Date well completed _____ 19____

Application for plugging filed 10-16 1962

Application for plugging approved 10-17 1962


Plugging commenced 10-18 1962

Plugging completed 11-19 1962

Reason for abandonment of well or producing formation Production declined, well no longer profitable

If a producing well is abandoned, date of last production _____ 19____

Was permission obtained from the Conservation Division or its agents before plugging was commenced? YES

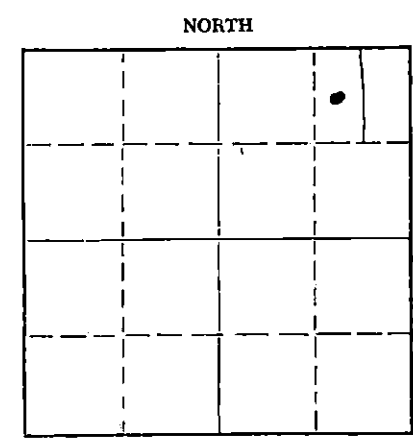

Locate well correctly on above Section Plat

Name of Conservation Agent who supervised plugging of this well Bill Lackamp

Producing formation _____ Depth to top _____ Bottom _____ Total Depth of Well 4223 Feet

Show depth and thickness of all water, oil and gas formations.

OIL, GAS OR WATER RECORDS

CASING RECORD

FORMATION	CONTENT	FROM	TO	SIZE	PUT IN	PULLED OUT
				10"	173	none
				5 1/2"	4222	2445.52

Describe in detail the manner in which the well was plugged, indicating where the mud fluid was placed and the method or methods used in introducing it into the hole. If cement or other plugs were used, state the character of same and depth placed, from _____ feet to _____ feet for each plug set.

Sand back bottom to 4100', and dumped
5 sacks of cement. Plugged surface with
15 sacks of mud and 75 sacks of cement.

RECEIVED
STATE CORPORATION COMMISSION

MAR 1 1963

CONSERVATION DIVISION
WICHITA, KANSAS

(If additional description is necessary, use BACK of this sheet)

Name of Plugging Contractor Pipe Pullers, Inc.
Address Box 486, Ellinwood, Kansas

STATE OF Kansas, COUNTY OF Barton, ss.
Dean Wells (employee of owner) or (~~owner or operator~~) of the above-described

well, being first duly sworn on oath, says: That I have knowledge of the facts, statements, and matters herein contained and the log of the above-described well as filed and that the same are true and correct. So help me God.

(Signature) Dean Wells

Ellinwood, Kansas
(Address)

SUBSCRIBED AND SWORN TO before me this 29th day of November, 1962

George A Meyer
Notary Public.

My commission expires Feb. 10, 1963



Drillers Log.

15-145-01162-6000

Company: Clark Knight Drg. Co; Inc.
Ewing #4.

Sec. 4, T23, R17W
S. CWL NE NE
Pawnee Co; Kansas.

Total depth. 4223'.
Comm. 4/21/56 Comp. 5/14/56

Casing.

8 5/8" 177' Cm. 125 sx.
5 1/2" 4222' Cm. 75 sx.

Figures to bottom of formation.

shale, shell	200'
	400
Sand, shale	425
Shale, shells	525
Sand	620
Shale, shells	1075
Anhydrite	1080
Shale, shells	1955
Lime	2080
Lime, shale	2245
Lime	2330
Lime, shale	3495
Line, shale	3689
Lime	3697
Shale	4104
Sand	4111
Shale, sand	4120
Lime	4174
Lime, shale	4220
T.D.	4223

Tops.

Elrv. 2054
Ahy. 1105
Lans. 3697
Ch.sd. 4111
Cong. 4121
Miss. 4174
Vib. 4188

RECEIVED
STATE CORPORATION COMMISSION

MAR 1 1963

CONSERVATION DIVISION
Wichita, Kansas