


WELL PLUGGING RECORD

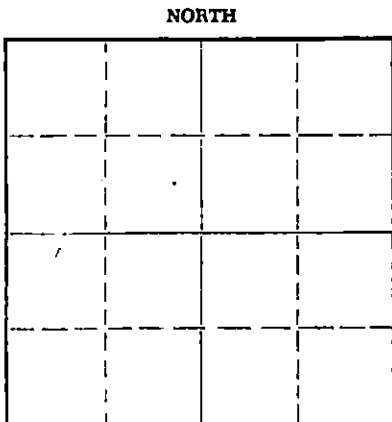

Locate well correctly on above Section Plat

Pawnee County, Sec. 4 Twp. 23 Rge. 10 (E) 17(W)
 Location as "NE/CNW/SW" or footage from lines SE/NW/SE
 Lease Owner Drilling And Exploration Company
 Lease Name C. Titus Well No. 7
 Office Address Exchange Bank Bldg., Dallas, Texas
 Character of Well (completed as Oil, Gas or Dry Hole) _____
 Date well completed _____ 19____
 Application for plugging filed _____ 19____
 Application for plugging approved _____ 19____
 Plugging commenced 11-16 19 61
 Plugging completed 11-24 19 61
 Reason for abandonment of well or producing formation _____

If a producing well is abandoned, date of last production _____ 19____
 Was permission obtained from the Conservation Division or its agents before plugging was commenced? Yes

Name of Conservation Agent who supervised plugging of this well W. L. Lackamp, Jr.
 Producing formation _____ Depth to top _____ Bottom _____ Total Depth of Well 4285 Feet
 Show depth and thickness of all water, oil and gas formations.

OIL, GAS OR WATER RECORDS				CASING RECORD		
FORMATION	CONTENT	FROM	TO	SIZE	PUT IN	PULLED OUT
				8 5/8"	225'	None
				5 1/8"	4284'	3170'

Describe in detail the manner in which the well was plugged, indicating where the mud fluid was placed and the method or methods used in introducing it into the hole. If cement or other plugs were used, state the character of same and depth placed, from _____ feet to _____ feet for each plug set.

Plug @ 4250
 Top Perforation @ 4196

Sanded to 4185' - dumped 5 sks cement - pulled casing - pumped in 25 sks Gel Mud and 50 sks cement in surface casing

Feed
1-3-62

JAN 3 1962

(If additional description is necessary, use BACK of this sheet)
 Name of Plugging Contractor R & D Casing Pulling Company License # 236
 Address Box # 572, Hutchinson, Kansas

STATE OF KANSAS, COUNTY OF SEDGWICK, ss.
Jack Shear (employee of owner) or (owner or operator) of the above-described

well, being first duly sworn on oath, says: That I have knowledge of the facts, statements, and matters herein contained and the log of the above-described well as filed and that the same are true and correct. So help me God.

(Signature) Jack Shear
Drilling And Exploration Company
701 Un. Natl. Bldg. Wichita, Kansas
 (Address)

SUBSCRIBED AND SWORN TO before me this 27th day of December 19 61

My commission expires September 24, 1962
Maxine Johnson
 Maxine Johnson Notary Public.



15-145-0155-0000

COPY


LOG BUREAU—KANSAS GEOLOGICAL SOCIETY
501 East Murdock, Wichita, Kansas

Company- DRILLING EXPLORATION CO.
Fams- Titus No. 7

SEC. 4 T. 23 R. 17W
SE NW SE

Total Depth 4285'
Comm- 8-17-55 Comp. 10-7-55
Shot Treated
Contractor
Issue Date 8-27-60

County Pawnee
KANSAS

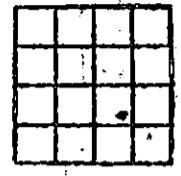

CASING:

8" 225'
5" 4283'

Elevation. 2073' RB

Production. 2995 BOPD

Figures indicate Bottom of Formations.

COMPLETE DRILLERS LOG NOT AVAILABLE.

TOPS: SCOUT	
Anhydrite	1105
Heebner	3623
Brown Lime	3730
Lansing	3737
Conglomerate	4150
Viola	4280

JAN 3 1962