


WELL PLUGGING RECORD

Give All Information Completely
Make Required Affidavit
Mail or Deliver Report to:
Conservation Division
State Corporation Commission
211 No. Broadway
Wichita, Kansas

NORTH

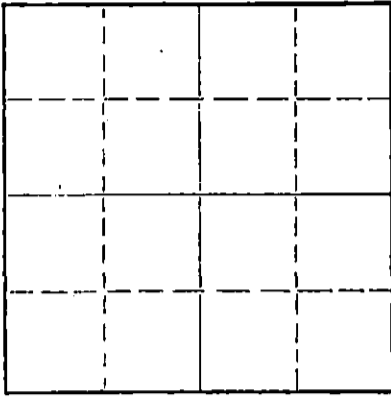

Locate well correctly on above Section Plat

Pawnee County, Sec. 4 Twp. 23 Rge. 17 (E) 11 (W)
Location as "NE/CNWSW" or footage from lines NW/SW/SE
Lease Owner Drilling And Exploration Company
Lease Name C. Titus Well No. 5
Office Address Exchange Bank Bldg., Dallas, Texas
Character of Well (completed as Oil, Gas or Dry Hole) _____
Date well completed _____ 19____
Application for plugging filed _____ 19____
Application for plugging approved _____ 19____
Plugging commenced 11-6 19 61
Plugging completed 11-13 19 61
Reason for abandonment of well or producing formation _____

If a producing well is abandoned, date of last production _____ 19____
Was permission obtained from the Conservation Division or its agents before plugging was commenced? Yes

Name of Conservation Agent who supervised plugging of this well W. L. Lackamp, Jr.
Producing formation _____ Depth to top _____ Bottom _____ Total Depth of Well 4282 Feet
Show depth and thickness of all water, oil and gas formations.

OIL, GAS OR WATER RECORDS

CASING RECORD

FORMATION	CONTENT	FROM	TO	SIZE	PUT IN	PULLED OUT
				8 5/8"	251'	None
				5 1/2"	4280'	3192'

Describe in detail the manner in which the well was plugged, indicating where the mud fluid was placed and the method or methods used in introducing it into the hole. If cement or other plugs were used, state the character of same and depth placed, from _____ feet to _____ feet for each plug set.

Plug @ 4250'
Top Perforation @ 4196'

Sanded to 4180' - dumped 5 sks cement - pulled casing - squeezed well with 20 sks Gel Mud and 75 sks cement through surface casing

Handwritten signature
1-3-62

JAN 3 1962

(If additional description is necessary, use BACK of this sheet)
Name of Plugging Contractor R & D Casing Pulling Company License # 236
Address Box # 572, Hutchinson, Kansas

STATE OF KANSAS COUNTY OF SEDGWICK, ss.
Jack Shear (employee of owner) or (owner or operator) of the above-described well, being first duly sworn on oath, says: That I have knowledge of the facts, statements, and matters herein contained and the log of the above-described well as filed and that the same are true and correct. So help me God.

(Signature) Jack Shear
Drilling And Exploration Company
701 Un. Natl. Bldg. Wichita, Kansas
(Address)

SUBSCRIBED AND SWORN TO before me this 27th day of December, 19 61

My commission expires September 24, 1962

Maxine Johnson
Maxine Johnson Notary Public.



COPY

LOG BUREAU—KANSAS GEOLOGICAL SOCIETY
500 East Murdock,
Wichita, Kansas


15-145-0153-0000

Company -- DRILLING EXPLORATION CO.
Farm-Titus No. 5

SEC. 4 - T 23 R. 17W
NW SW SE

Total Depth 4282'
Comm-7-20-55 Comp. 8-19-55
shot treated
Contractor
Issue Date 8-27-60

County Pawnee
KANSAS

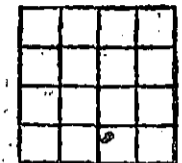

CASING: .

5" 4280

Elevation: 2022'

Production. 3000 BOPD

Figures indicate Bottom of Formations.

COMPLETE DRILLERS LOG NOT AVAILABLE.

TOPS: SCOUT	
Heebner	3610
Lansing	3740
Conglomerate	4145
Viola	4275

JAN 3 1962