

WELL PLUGGING RECORD


Give All Information Completely
Make Required Affidavit
Mail or Deliver Report to:
Conservation Division
State Corporation Commission
211 No. Broadway
Wichita, Kansas

Pawnee

County, Sec. 4 Twp. 23 Rge. 17 (E) 11 (W)

Location as "NE/CNW/SW" or footage from lines SE/SE/SE
Lease Owner Drilling And Exploration Company
Lease Name G. Titus Well No. 4
Office Address Exchange Bank Bldg., Dallas, Texas
Character of Well (completed as Oil, Gas or Dry Hole) _____
Date well completed _____ 19____
Application for plugging filed _____ 19____
Application for plugging approved _____ 19____
Plugging commenced _____ 11-27 1961
Plugging completed _____ 12-8 1961
Reason for abandonment of well or producing formation _____

NORTH

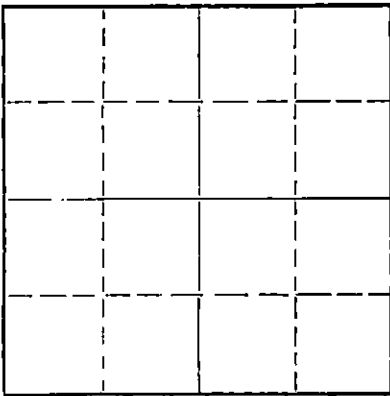

Locate well correctly on above
Section Plat

If a producing well is abandoned, date of last production _____ 19____
Was permission obtained from the Conservation Division or its agents before plugging was commenced? Yes

Name of Conservation Agent who supervised plugging of this well W. L. Lackamp, Jr.
Producing formation _____ Depth to top _____ Bottom _____ Total Depth of Well 4309 Feet
Show depth and thickness of all water, oil and gas formations.

OIL, GAS OR WATER RECORDS

CASING RECORD

FORMATION	CONTENT	FROM	TO	SIZE	PUT IN	PULLED OUT
				8 5/8"	208'	None
				5 1/2"	4309'	3180'

Describe in detail the manner in which the well was plugged, indicating where the mud fluid was placed and the method or methods used in introducing it into the hole. If cement or other plugs were used, state the character of same and depth placed, from _____ feet to _____ feet for each plug set.

Plug @ 4220'
Top Perforation @ 4196'

Sanded to 4185' - dumped 5 sks cement -
pulled casing - pumped in 20 sks Gel
Mud and 50 sks cement in surface pipe

JAN 8 1962

Read
1-3-62

(If additional description is necessary, use BACK of this sheet)
Name of Plugging Contractor R & D Casing Pulling Company License # 236
Address Box # 572, Hutchinson, Kansas

STATE OF KANSAS COUNTY OF SEDGWICK, ss.
Jack Shear (employee of owner) or (owner or operator) of the above-described

well, being first duly sworn on oath, says: That I have knowledge of the facts, statements, and matters herein contained and the log of the above-described well as filed and that the same are true and correct. So help me God.

(Signature) Jack Shear
By Drilling And Exploration Company
701 Un. Natl. Bldg. Wichita, Kansas
(Address)

SUBSCRIBED AND SWORN TO before me this 27th day of December, 1961

My commission expires September 24, 1962 Maxine Johnson Notary Public.

COPY

15-145-0152-0000

LOG BUREAU—KANSAS GEOLOGICAL SOCIETY
500 East Murdock, Wichita, Kansas


Company- DRILLING & EXPLORATION CO.
FARM- TITUS No. 4

SEC. 4 T. 23 R. 17W
SE SE SE

Total Depth 4311'
Comm-7-13-55
Shot or treated
Contractor
Issue Date 8-27-60

Comp. 8-12-55

County Pawnee
KANSAS

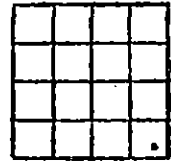

CASING:

8" 208'
5" 4311'

Elevation. 2101'

Production. 3000 BOPD

Figures indicate Bottom of Formations.

COMPLETE DRILLERS LOG NOT AVAILABLE.

TOPS: SCOUT	
Anhydrite	3676
Broan Lime	3755
Lansing	3765
Shale Conglomerate	4137
Chat Conglomerate	4200
Viola	4299

JAN 8 1962