

15-145-01171-0600

STATE OF KANSAS  
STATE CORPORATION COMMISSION

STATE CORPORATION COMMISSION  
JUN 20 1958

WELL PLUGGING RECORD

Give All Information Completely  
Make Required Affidavit  
Mail or Deliver Report to:  
Conservation Division  
State Corporation Commission  
211 No. Broadway  
Wichita, Kansas

CONSERVATION DIVISION  
Wichita, Kansas

6-20-58

Pawnee County, Sec. 4 Twp. 23 Rge. 17 (E) W (W)

Location as "NE/CNW/SW" or footage from lines SE SW NW

Lease Owner Sunray Mid-Continent Oil Co.

Lease Name V. Davis #2 Well No.

Office Address Great Bend, Kansas

Character of Well (completed as Oil, Gas or Dry Hole) Oil

Date well completed April 25, 1955

Application for plugging filed May 26, 1958

Application for plugging approved May 28, 1958

Plugging commenced 6-10-58 19


Plugging completed 6-14-58 19

Reason for abandonment of well or producing formation

Reached economic limit

If a producing well is abandoned, date of last production March 7, 1958

Was permission obtained from the Conservation Division or its agents before plugging was commenced? yes

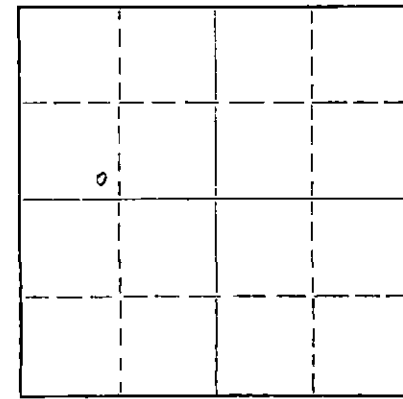

Locate well correctly on above Section Plat

Name of Conservation Agent who supervised plugging of this well Frank Broadfoot

Producing formation Depth to top Bottom Total Depth of Well 4285' Feet

Show depth and thickness of all water, oil and gas formations.

OIL, GAS OR WATER RECORDS

CASING RECORD

FORMATION	CONTENT	FROM	TO	SIZE	PUT IN	PULLED OUT
				8-5/8"	306'	none
				5-1/2"	4270'	3163'

Describe in detail the manner in which the well was plugged, indicating where the mud fluid was placed and the method or methods used in introducing it into the hole. If cement or other plugs were used, state the character of same and depth placed, from \_\_\_\_\_ feet to \_\_\_\_\_ feet for each plug set.

Checked the hole to 4235' and found it open.  
Filled w/sand to 4150' and ran 5 sacks of cement. Pulled 5 1/2" casing and squeezed with 10 sacks of gel mud and 75 sacks of cement. Mudded hole to 30', set rock bridge and ran 5 sacks of cement to base of cellar.

(If additional description is necessary, use BACK of this sheet)

Name of Plugging Contractor West Supply Co., Inc.

Address Chase, Kansas

STATE OF KANSAS, COUNTY OF RICE, ss.

N. E. Montgomery (employee of owner) or (owner/contractor) of the above-described

well, being first duly sworn on oath, says: That I have knowledge of the facts, statements, and matters herein contained and the log of the above-described well as filed and that the same are true and correct. So help me God.

(Signature) N. E. Montgomery

Box # 788, Great Bend, Kansas (Address)

SUBSCRIBED AND SWORN TO before me this 17th day of June, 19 58

Thomas V. Duggan

Notary Public.

My commission expires 9-27-58



PLUGGING  
FILE SEC 4 T 23 R 17W  
BOOK PAGE 103 LINE 15

15-45-01171-0000

Sunray Oil Corporation  
Tulsa, Oklahoma

Tulsa, Oklahoma  
April 26, 1955

CONTRACTOR: Stickle Drilling Company  
Drilling Commenced: April 5, 1955  
Drilling Completed: April 18, 1955

V. Davis #2 SE/4 NW/4  
Sec. 4-238-17W, Pawnee  
County, Kansas.

DRILLERS LOG

Sandy Gravel	0-40
Clay & Shale	40-150
Shale & Shells	150-307
Shale & Red Bed	307-550
Sand	550-625
Shale	625-820
Red Bed	820-1090
Anhydrite	1090-1125
Shale & Shells	1125-1330
Shale & Lime	1330-1665
Shale & Shells	1665-1925
Shale	1925-2125
Shale & Lime	2125-2265
Lime & Shale	2265-2508
Lime	2508-2635
Shale & Lime	2635-2875
Shale	2875-3140
Lime & Shale	3140-3586
Shale & Lime	3586-3674
Lime & Shale	3674-3842
Lime	3842-4008
Lime & Shale	4008-4062
Lime	4062-4160
Cherty Lime	4160-4168
Lime	4168-4270 TD

I, Frank E. Stickle, hereby certify the above to be a true and complete Drillers Log of Sunray Oil Corporation's V. Davis #2 SE/4 NW/4 Section 4-238-17W, Pawnee County, Kansas.

Frank E. Stickle  
Frank E. Stickle

Lillian T. Bonham  
Notary Public

February 13, 1956  
My Commission Expires

RECEIVED  
STATE CORPORATION COMMISSION  
JUN 20 1958  
CONSERVATION DIVISION  
Tulsa, Kansas

PLUGGING  
FILE SEC. 4 T. 23 R. 17W  
BOOK PAGE 103 LINE 15