


Give All Information Completely
Make Required Affidavit
Mail or Deliver Report to:
Conservation Division
State Corporation Commission
800 Bittling Building
Wichita, Kansas

WELL PLUGGING RECORD
OR
FORMATION PLUGGING RECORD

Strike out upper line
when reporting plug-
ging of formations.

15-009-05556-0000

NORTH

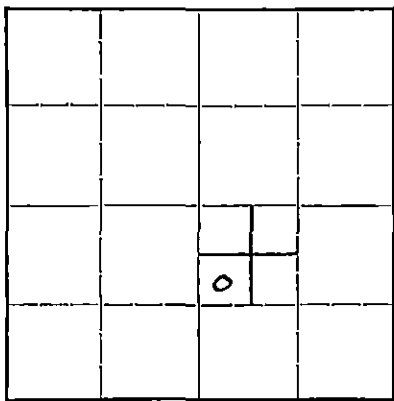

Locate well correctly on above
Section Plat

Barton County, Sec. 36 Twp. 16 Rge. 11 (W)
Location as "NE 1/4 NW 1/4 SW 1/4" or footage from lines SW 1/4 NW 1/4 SE 1/4
Lease Owner G. W. Keyes Drilling Company
Lease Name Blue Well No. 1
Office Address Ellinwood, Kansas
Character of Well (completed as Oil, Gas or Dry Hole) Dry Hole
Date, well completed May 17, 1946 19
Application for plugging filed May 17, 1946 19
Application for plugging approved May 17, 1946 19
Plugging Commenced May 17, 1946 19
Plugging Completed May 17, 1946 19
Reason for abandonment of well or producing formation Dry Hole

If a producing well is abandoned, date of last production - - - - - 19
Was permission obtained from the Conservation Division or its agents before plugging was com-
menced? Yes

Name of Conservation Agent who supervised plugging of this well H. W. Kerr
Producing formation none Depth to top - - - Bottom - - - Total Depth of Well 3387 Feet
Show depth and thickness of all water, oil and gas formations.

OIL, GAS OR WATER RECORDS

CASING RECORD

Formation	Content	From	To	Size	Put In	Pulled Out
		0	182	8 5/8	182'	none
		0	3386	5 1/2	3386'	1937' 8"

Describe in detail the manner in which the well was plugged, indicating where the mud fluid was placed and the method or methods used in introducing it into the hole. If cement or other plugs were used, state the character of same and depth placed, from - - - feet to - - - feet for each plug set.

Filled with rock from 3384 to 3140; cemented with 8 sacks at 3140; mudded hole from 3140 to 180; set bridge and cemented with 15 sacks cement; mudded back to 15 feet and cemented with 10 sacks of cement, cement returning to top of surface pipe.

PLUGGING
FILE SEC 36 T16 R11W
BOOK PAGE 54 LINE 40

MAY 23 1946
WICHITA, KANSAS

(If additional description is necessary, use BACK of this sheet)

Correspondence regarding this well should be addressed to G. W. Keyes Drilling Company
Address Ellinwood, Kansas

STATE OF Kansas, COUNTY OF Barton, ss.
I, G. W. Keyes, part owner (employee of owner) or (owner or operator) of the above-described well,
being first duly sworn on oath, says: That I have knowledge of the facts, statements, and matters herein contained and the log of the above-described well as filed and that the same are true and correct. So help me God.

(Signature) *G. W. Keyes*
Ellinwood, Kansas
(Address)

SUBSCRIBED AND SWORN to before me this 20th day of May, 19 46

J. J. Rader

Notary Public.

My commission expires July 7, 1948

WELL LOG

15 00905556-0000

G. W. Keyes Drilling Co. et al - Owners
Blue #1
SW NW SE Section 36, Township 16 S, Range 11 W,
Barton County, Kansas

Figures indicate bottom of formation

	0	to	20 clay
			182 blue shale
Elevation: 1909			680 red bed
			708 anhydrite
			780 red bed
Pipes:			1455 shale and shells
8 5/8" set at 182'			1617 shale and lime shells
5 1/2" set at 3383'			1775 shale and shells
			1875 sandy lime
Tops:			1975 lime
Topeka Lime	2630	DF	2165 lime and shale
Heebner Shale	2899	"	2310 broken lime and shells
Base Oread	2931	"	2595 shale and shells
Brown Lime	3013	"	2656 shale
Lansing	3033	"	2954 lime
Chert Conglomerate	3353	"	3059 shale and lime
Arbuckle Dolomite	3383	"	3293 lime
			3329 lime and shale
			3387 lime
			3387 total depth, D & A

Rotary Commenced Feb. 19, 1946
Rotary completed Mar. 3, 1946

Cable Tool Work

Cable tools commenced
May 4, 1946
Completed May 11, 1946
Dry and Abandoned May 18, 1946

Moved in cable tools, bailed hole dry, perforated from 3234 to 3245 and from 3141 to 3151. Swabbed 110 feet of muddy and rusty water per hour after perforating from 3141 to 3151.

State of Kansas)
County of Barton) SS

I, G. W. Keyes, Part Owner of the above-described well, being first duly sworn on oath, declare; That I have knowledge of the facts, statements and matters herein contained pertaining to the log of the above-described well as filed and that the same are true and correct.

G. W. Keyes

Subscribed and Sworn to before me this 22nd day of May, 1946.

J. J. Rader
Notary Public
STATE OF KANSAS
COMMISSION
MAY 23 1946
BARTON COUNTY

My commission expires July 7, 1948

36 16 11W
54 40