


WELL PLUGGING RECORD

Give All Information Completely  
Make Required Affidavit  
Mail or Deliver Report to:  
Conservation Division  
State Corporation Commission  
800 Bittling Building  
Wichita, Kansas

NORTH

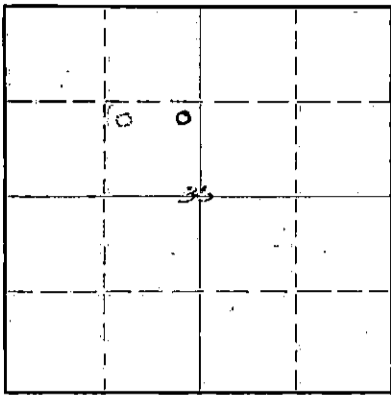

Locate well correctly on above Section Flat

Barton County. Sec. 36 Twp. 16S Rge. 11 (E) (W)  
Location as "NE/CNW $\frac{1}{4}$ SW $\frac{1}{4}$ " or footage from lines NE SE NW  
Lease Owner J. J. Lynn  
Lease Name Kraft Well No. 3  
Office Address 1000 R.A. Long Bldg., Kansas City 6, Missouri  
Character of Well (completed as Oil, Gas or Dry Hole) Dry Hole  
Date well completed July 15, 19 49  
Application for plugging filed July 14, 19 49  
Application for plugging approved July 11, 19 49  
Plugging commenced July 15, 19 49  
Plugging completed July 15, 19 49  
Reason for abandonment of well or producing formation Dry Hole

If a producing well is abandoned, date of last production 19  
Was permission obtained from the Conservation Division or its agents before plugging was commenced? Yes

Name of Conservation Agent who supervised plugging of this well C. D. Stough  
Producing formation Depth to top Bottom Total Depth of Well 3431 Feet  
Show depth and thickness of all water, oil and gas formations.

OIL, GAS OR WATER RECORDS

CASING RECORD

Formation	Content	From	To	Size	Put In	Pulled Out
				8-5/8"	257'	

Describe in detail the manner in which the well was plugged, indicating where the mud fluid was placed and the method or methods used in introducing it into the hole. If cement or other plugs were used, state the character of same and depth placed, from feet to feet for each plug set.

Filled with heavy mud to 255 feet. Set plug. Dumped 15 sacks cement through drill pipe. Filled with heavy mud to within 30 feet of surface. Set plug. Dumped 10 sacks cement.

RECEIVED  
JUL 22 1949  
7-22-1949  
ST. CORPORATION  
MISSION  
KANSAS

(If additional description is necessary, use BACK of this sheet)


Correspondence regarding this well should be addressed to Joseph H. Lane, Geologist,  
Address c/o J. J. Lynn, 113 $\frac{1}{2}$  S. E. 1st Avenue, Mineral Wells, Texas.

STATE OF Kansas COUNTY OF Rice ss.  
Rollin Mead (employee of owner) or (owner or operator) of the above-described well,  
being first duly sworn on oath, says: That I have knowledge of the facts, statements, and matters herein contained and the log of the above-described well as filed and that the same are true and correct. So help me God.

(Signature) Rollin Mead  
Sterling, Kansas  
(Address)

SUBSCRIBED AND SWORN to before me this 21st day of July, 19 49.

My commission expires September 17, 1949.

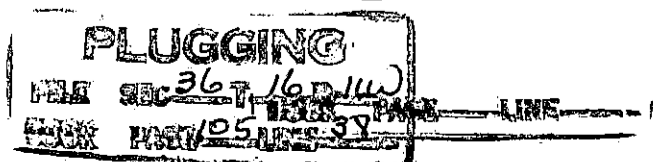

STERLING DRILLING COMPANY

15-009-05509-0000

STERLING, KANSAS

WELL LOG ----- KRAFT NO. 3

Location - NE SE NW of Section 36-16S-11W, Barton County, Kansas.

Owner - J. J. Lynn, 1000 R. A. Long Building, Kansas City 6, Missouri.

Contractor - Sterling Drilling Company, Sterling, Kansas.

Commenced - 6-30-49

Completed - 7-15-49

Total Depth - 3431'

LOG

CASING RECORD

0- 205 Shale  
 205- 257 Shale and Lime Shells  
 257- 485 Shale and Shells  
 485- 630 Shale and Red Rock  
 630- 663 Anhydrite  
 663- 690 Shale and Shells  
 690-1100 Shale  
 1100-1305 Salt and Shale  
 1305-1410 Shale  
 1410-1460 Lime  
 1460-1920 Shale and Lime  
 1920-2090 Lime  
 2090-2130 Shale and Shells  
 2130-2260 Shale  
 2260-2350 Shale and Lime  
 2350-2435 Lime Shells and Shale  
 2435-2570 Shale and Shells  
 2570-2675 Lime and Shale  
 2675-2685 Shale  
 2685-3005 Lime  
 3005-3050 Shale and Lime  
 3050-3355 Lime  
 3355-3400 Conglomerate  
 3400-3431 Lime

257 Feet 8-5/8" Surface Pipe  
Cemented with 125 Sacks Cement.

PRODUCTION

None. Dry and Abandoned.

RECEIVED


JUL 22 1949

STATE CORPORATION  
COMMISSION  
KANSAS

PLUGGING  
 FILE DEC 30 1949  
 BOOK PAGE 125 LINE 38