


STATE OF KANSAS
STATE CORPORATION COMMISSION

WELL PLUGGING RECORD

FORMATION PLUGGING RECORD

Give All Information Completely
Make Required Affidavit
Mail or Deliver Report to:
Conservation Division
State Corporation Commission
300 Bitting Building
Wichita, Kansas

Strike out upper line
when reporting plug-
ging off formations.

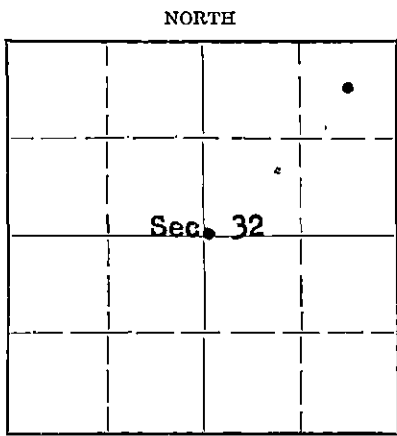

Locate well correctly on above
Section Plot

Trego County, Sec. 32 Twp. 11S Rge. 24 (E) W (W)

Location as "NE 1/4 NW 1/4 SW 1/4" or footage from lines Center of NE 1/4 NE 1/4

Lease Owner Stanolind Oil and Gas Company

Lease Name Ernest Jesse Well No. 1

Office Address Box 591, Tulsa, Oklahoma

Character of Well (completed as Oil, Gas or Dry Hole) Dry Hole

Date well completed October 22 19 49

Application for plugging filed October 22 19 49

Application for plugging approved October 22 19 49

Plugging commenced October 22 19 49

Plugging completed October 22 19 49

Reason for abandonment of well or producing formation Dry Hole

If a producing well is abandoned, date of last production 19

Was permission obtained from the Conservation Division or its agents before plugging was com-
menced? Yes

Name of Conservation Agent who supervised plugging of this well Petty

Producing formation Depth to top Bottom Total Depth of Well 4515 Feet

Show depth and thickness of all water, oil and gas formations.

OIL, GAS OR WATER RECORDS

CASING RECORD

| Formation | Content | From | To | Size | Put In | Pulled Out |
|-------------|-------------|------|----|---------|--------|------------|
| | | | | 13-3/8" | 228' | 0 |
| Lansing | Dry | 3403 | | | | |
| Marmaton | Dry | 3884 | | | | |
| Mississippi | Show of Oil | 4022 | | | | |
| Viola | Dry | 4266 | | | | |
| Arbuckle | Dry | 4339 | | | | |

Describe in detail the manner in which the well was plugged, indicating where the mud fluid was placed and the method or methods used in introducing it into the hole. If cement or other plugs were used, state the character of same and depth placed, from feet to feet for each plug set.

Drilling Mud from 4515' (TD) to 238'

Cement Plug from 238' to 216' (20 sack)

Drilling Mud from 216' to 26'

Cement Plug from 26' to 6' (Bottom of Cellar) (10 sacks)

RECEIVED

OCT 27 1949

STATE CORPORATION
COMMISSION
KANSAS

(If additional description is necessary, use BACK of this sheet)

Correspondence regarding this well should be addressed to Mr. C. B. Snyder
Address Box 35
Gorham, Kansas

STATE OF Kansas, COUNTY OF Russell, ss.

C. B. Snyder (employee of owner) of the above-described well,
being first duly sworn on oath, says: That I have knowledge of the facts, statements, and matters herein contained and the log of the above-described well as filed and that the same are true and correct. So help me God.


(Signature) C. B. Snyder

Box 35, Gorham, Kansas (Address)

SUBSCRIBED AND SWORN to before me this 24th day of October, 19 49

Celeste Sanders
Notary Public.

My commission expires 2/25/50

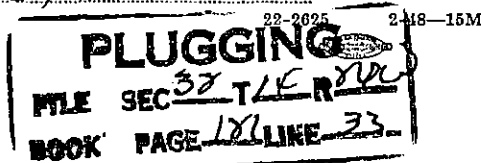

FORMATION RECORD

DESCRIBE EACH FORMATION DRILLED. INDICATE THICKNESS, CONTENT AND WHETHER DRY, OR OIL, GAS, OR WATER BEARING.

| FORMATION | TOP | BOTTOM | FORMATION | TOP | BOTTOM |
|---|----------|--------|-----------|-----|--------|
| Sand | 0 | 20 | | | |
| Shale | 20 | 65 | | | |
| Sand & Shale | 65 | 225 | | | |
| Shale & Shells | 225 | 284 | | | |
| Shale | 284 | 390 | | | |
| Shale, Shale & Sand | 390 | 530 | | | |
| Sand & Shale | 530 | 670 | | | |
| Sand, Shale & Iron | 670 | 800 | | | |
| Shale & Shells | 800 | 1055 | | | |
| Red Bed Shale & Shells | 1055 | 1170 | | | |
| Sand | 1170 | 1395 | | | |
| Red Bed, Shale & Shells | 1395 | 1665 | | | |
| <u>TOP ANHYDRITE #603 1617</u> | | | | | |
| Anhydrite | 1665 | 1695 | | | |
| Shale & Shells | 1695 | 2180 | | | |
| Lime | 2180 | 2515 | | | |
| Lime & Shale | 2515 | 2605 | | | |
| Lime | 2605 | 2710 | | | |
| Lime & Shale | 2710 | 3335 | | | |
| Lime | 3335 | 3420 | | | |
| <u>TOP HEBNER -1119 3369</u> | | | | | |
| <u>TOP YANING -1153 3403</u> | | | | | |
| Lime | 3420 | 3820 | | | |
| Lime & Shale | 3820 | 3955 | | | |
| <u>TOP MARIATON -1634 3984</u> | | | | | |
| Lime | 3955 | 3985 | | | |
| Lime & Shale | 3985 | 4045 | | | |
| <u>TOP MISSISSIPPI -1772 4022</u> | | | | | |
| <u>TEST #1 @ TD 4041 with packer</u> @ 4029 tool open one hour 1/2" choke. Recovered 25 ft. mud and 19 ft. oil BP zero corrected gravity 37.9. | | | | | |
| Lime | 4045 | 4100 | | | |
| Lime & Chert | 4100 | 4130 | | | |
| Cherty Conglomerate | 4130 | 4141 | | | |
| Zone 4129 to 33 show live oil poor porosity | | | | | |
| <u>TEST #2 TD 4141 packer set at</u> 4129, 1/2" choke, tool open 2 hours and closed 15 min. Recovered 100 ft. water cut mud with specks of oil. BP 1020. | | | | | |
| Chert, Lime & Shale | 4141 | 4185 | | | |
| Lime | 4185 | 4295 | | | |
| <u>TOP VIGIA -2016 4266</u> | | | | | |
| Lime | 4295 | 4365 | | | |
| <u>TOP ARBUCKLE -2089 4339</u> | | | | | |
| <u>TEST #3 TD 4365 packer set at</u> 4339 tool open 1 hour, 1/2" choke. Recovered 240 ft. water. BP 1040 | | | | | |
| Lime | 4365 | 4475 | | | |
| Lime & Chert | 4475 | 4515 | | | |
| Ran Schlumberger Survey de- tailed 3200 to TD 4515 | | | | | |
| Completed as Dry Hole | 10-22-49 | | | | |
| Location Staked | 9-19-49 | | | | |
| RFW | 9-22-49 | | | | |
| Spudded | 10-2-49 | | | | |
| Ran Surface Casing | 10-3-49 | | | | |

STANOLIND OIL AND GAS COMPANY
FIELD PURCHASE ORDER

No L71294

DATE October 22 1949

ORDERED FROM

State Corporation Commission

ADDRESS

800 Petens Building Wichita Kansas

RENDER INVOICE IN DUPLICATE FOR EACH ORDER, SHOW ORDER NUMBER ON ALL COPIES OF INVOICE AND MAIL TO

STANOLIND OIL AND GAS COMPANY

BarhamKansas

CITY

STATE

CONTRACTOR 1

| QUANTITY | DESCRIPTION | FEA | SYM | UNIT PRICE | AMOUNT |
|----------|----------------------------|-----|-----|------------|--------------|
| | <u>Fee for Supervising</u> | | | | |
| | <u>plugging dry hole</u> | | | | <u>25.00</u> |
| | | | | | |
| | | | | | |
| | | | | | |
| | | | | | |
| | | | | | |
| | | | | | |
| | | | | | |

CHARGE TO

Ernest Lease Inc Well #1

USED FOR

To plug and abd. dry hole

ORIG. CONST.

 OPERATIONS

REPLACEMENT

 REPAIRS

TERMS

net

STANOLIND OIL AND GAS COMPANY

By acceptance of this order, Seller represents that the sale of the article or articles referred to herein, and the price therefor and delivery thereof will conform to all applicable federal and state laws, orders, rules and regulations.

By

Earl W. Barnett

CONTRACTOR AGREES THAT IN THE PERFORMANCE OF THE ABOVE WORK, CONTRACTOR SHALL ACT SOLELY AS AN INDEPENDENT CONTRACTOR AND AS SUCH IS SOLELY RESPONSIBLE FOR ALL CONTRIBUTIONS AND TAXES IMPOSED UNDER UNEMPLOYMENT COMPENSATION OR INSURANCE LAWS COVERING EMPLOYEES OF CONTRACTOR. CONTRACTOR GUARANTEES THAT ALL MATERIAL SOLD AND DELIVERED HEREUNDER HAS BEEN OR WILL BE PRODUCED, AND ALL WORK, LABOR AND SERVICES PERFORMED HEREUNDER HAS BEEN OR WILL BE PERFORMED AND PRICES THEREFOR HAVE BEEN OR WILL BE CHARGED IN STRICT ACCORDANCE WITH ALL APPLICABLE STATE AND FEDERAL LAWS, RULES, REGULATIONS AND ORDERS.