


STATE OF KANSAS  
STATE CORPORATION COMMISSION

Give All Information Completely  
Make Required Affidavit  
Mail or Deliver Report to:  
Conservation Division  
State Corporation Commission  
800 Bittling Building  
Wichita, Kansas

WELL PLUGGING RECORD

NORTH

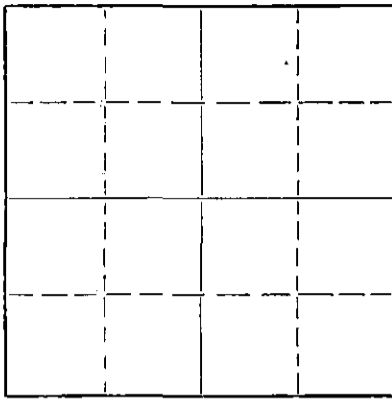

Locate well correctly on above  
Section Plat

Trego County. Sec. 15 Twp. 14S Rge.      (E) 24 (W)  
Location as "NE/CNW/SW" or footage from lines NE: NE SW  
Lease Owner Jones, Shelburne & Farmer, Inc.  
Lease Name Deines Well No. 1  
Office Address Russell, Kansas  
Character of Well (completed as Oil, Gas or Dry Hole) Dry  
Date well completed 8-12 19 52  
Application for plugging filed 8-12 19 52  
Application for plugging approved 8-12 19 52  
Plugging commenced 8-12 19 52  
Plugging completed 8-12 19 52  
Reason for abandonment of well or producing formation Dry

If a producing well is abandoned, date of last production Never produced 19       
Was permission obtained from the Conservation Division or its agents before plugging was commenced? yes

Name of Conservation Agent who supervised plugging of this well Elden Petty  
Producing formation      Depth to top      Bottom      Total Depth of Well 4450 Feet  
Show depth and thickness of all water, oil and gas formations.

OIL, GAS OR WATER RECORDS

CASING RECORD

FORMATION	CONTENT	FROM	TO	SIZE	PUT IN	PULLED OUT
				8 5/8	185'	None

Describe in detail the manner in which the well was plugged, indicating where the mud fluid was placed and the method or methods used in introducing it into the hole. If cement or other plugs were used, state the character of same and depth placed, from      feet to      feet for each plug set.

1. Filled hole with heavy mud to 180'
2. Pushed Halliburton plug 180'
3. Dumped in 1/2 sack of hulls on top of plug
4. Mixed and dumped 15 sacks of cement on top of hulls.
5. Filled hole to 40'
6. Pushed second Halliburton plug to 40'
7. Dumped 1/2 sack of hulls on top of plug
8. Mixed 10 sacks of cement and filled hole with same

(If additional description is necessary, use BACK of this sheet)  
Name of Plugging Contractor Jones, Shelburne & Farmer, Inc.  
Address Russell, Kansas

RECEIVED  
STATE CORPORATION COMMISSION  
AUG 18 1952  
CONSERVATION DIVISION  
WICHITA, KANSAS

STATE OF     , COUNTY OF     , ss.      (employee of owner) or (owner or operator) of the above-described well, being first duly sworn on oath, says: That I have knowledge of the facts, statements, and matters herein contained and the log of the above-described well as filed and that the same are true and correct. So help me God.

(Signature) John W. Farmer  
(Address)     

SUBSCRIBED AND SWORN TO before me this 14 <sup>th</sup> day of August, 1952  
Bonnie Berryhill  
Notary Public.

My commission expires April 23, 1956

PLUGGING  
WELL SEC. 15 T. 14 R. 24 E.  
DATE 31, 1952


OPERATOR Jones, Shelburne & Farmer, Inc.

FORMATION RECORD

Give detailed description and thickness of all formations drilled through, contents of card, whether dry, water, oil or gas.

ADDRESS Russell, Kansas

640 Acres  
N

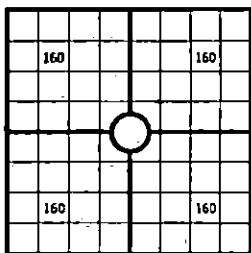

Locate well correctly

COUNTY Trego SEC. 15 TWP. 14S RGE 24W  
COMPANY OPERATING Jones, Shelburne & Farmer, Inc.

OFFICE ADDRESS Russell, Kansas

FARM NAME Deines WELL NO. 1

DRILLING STARTED 7-29 1952 DRILLING FINISHED 8-12 1952

DATE OF FIRST PRODUCTION \_\_\_\_\_ COMPLETED \_\_\_\_\_

WELL LOCATED NE 1/4 NE 1/4 SW 1/4 North of South  
Line and \_\_\_\_\_ ft. East of West Line of Quarter Section

Elevation (Relative to sea level) DERRICK FLOOR 2268 FEET

CHARACTER OF WELL (Oil, gas or dryhole) Dry

OIL OR GAS SANDS OR ZONES

Name	From	To	Name	From	To
			4		
			5		
			6		

Perforating Record If Any

Shot Record

From	To	No. of Shots	Formation	From	To	Size of Shot

CASING RECORD

Amount Set				Amount Pulled				Packer Record			
Size	Wt.	Thds	Make	Ft.	In	Ft.	In	Size	Length	Depth Set	Make
5/8	24	18	LW	185				None			

Liner Record: Amount \_\_\_\_\_ Kind \_\_\_\_\_ Top \_\_\_\_\_ Bottom \_\_\_\_\_

CEMENTING AND MUDDING

Size	Amount Set		Sacks Cement	Chemical		Method of Cementing	Amount	Mudding Method	Results (See Note)
	Ft.	In.		Gal.	Make				

Note: What method was used to protect sands if outer strings were pulled? \_\_\_\_\_

NOTE: Were bottom hole plugs used? \_\_\_\_\_ If so, state kind, depth set and results obtained \_\_\_\_\_

TOOLS USED

Rotary Tools were used from \_\_\_\_\_ feet to \_\_\_\_\_ feet  
Cable tools were used from \_\_\_\_\_ feet to \_\_\_\_\_ feet,  
and from \_\_\_\_\_ feet to \_\_\_\_\_ feet, and from \_\_\_\_\_ feet to \_\_\_\_\_ feet

Type Rig \_\_\_\_\_

INITIAL PRODUCTION TEST

Describe initial test: whether by flow through tubing or casing or by pumping \_\_\_\_\_

Amount of Oil Production \_\_\_\_\_ bbls. Size of choke, if any \_\_\_\_\_ Length of test \_\_\_\_\_ Water

Production \_\_\_\_\_ bbls. Gravity of oil \_\_\_\_\_ Type of Pump if pump is used, describe \_\_\_\_\_

Formation	Top	Bottom	Formation	Top	Bottom
Cellar	0	165			
Shale & Sand	165	575			
Shale Shells Sand	575	1420			
Shale & Shells	1420	1685			
Anhydrite	1685	1725			
Shale & Shells	1725	2580			
Lime & Shale	2580	3510			
Lime & Shale	3510	3700			
Lime	3700	3865			
Lime & Shale	3865	4255			
Lime Shale, Chert	4255	4275			
Chert, Fine Shale	4275	4300			
Lime & Shale	4300	4335			
Lime	4335	4390			
Lime & Shale	4390	4423			
Dolomite	4423	4450			

TOPS:

Elevation 2265  
Heebner 3551  
Toronto 3570  
Lansing 3595  
Base of K. G. 3869  
Marmaton Lime 3938  
Fort Scott 3995  
Mississippi 4163  
Viola 4302  
Simpson 4418  
Arbuckle 4423  
Total Depth 4450

D & A

I, the undersigned, being first duly sworn upon oath, state that this well record is true, correct and complete according to the records of this office and to the best of my knowledge and belief.

*John D. Farmer*  
Notary Public

Subscribed and sworn to before me this 14th day of August 1952  
My Commission expires April 23, 1956  
*Bonnie Berryhill*  
Notary Public

FARM NAME Deines, COUNTY Trego, WELL NO. 1, COUNTY Trego, SEC. 15, TWP. 14S., RGE. 24W