


WELL PLUGGING RECORD

Give All Information Completely
Make Required Affidavit
Mail or Deliver Report to:
Conservation Division
State Corporation Commission
212 No. Market
Wichita, Kansas

Trego County, Sec. 26 Twp. 14S Rge. 11E/21 (W)

Location as "NE/CNW/SW" or footage from lines SE SE SE
Lease Owner Abercrombie Drilling, Inc.
Lease Name Ethel Moore Well No. 1
Office Address 801 Union Center, Wichita, Kansas
Character of Well (completed as Oil, Gas or Dry Hole) Dry Hole
Date well completed 11-2 19 66
Application for plugging filed (Verbally) 11-1 19 66
Application for plugging approved (Verbally) 11-1 19 66
Plugging commenced 11-2 19 66
Plugging completed 11-2- 19 66
Reason for abandonment of well or producing formation Dry Hole

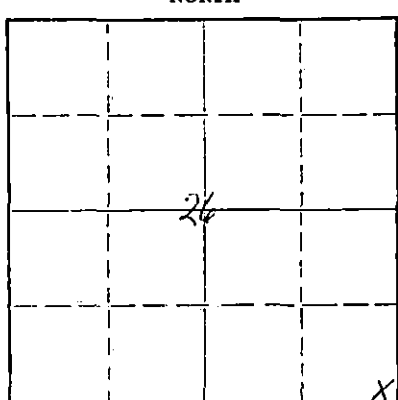

Locate well correctly on above Section Plat

If a producing well is abandoned, date of last production 19
Was permission obtained from the Conservation Division or its agents before plugging was commenced? Yes

Name of Conservation Agent who supervised plugging of this well W. H. Nichols, Moreland, Kansas
Producing formation _____ Depth to top _____ Bottom _____ Total Depth of Well 3883 Feet
Show depth and thickness of all water, oil and gas formations.

OIL, GAS OR WATER RECORDS

CASING RECORD

FORMATION	CONTENT	FROM	TO	SIZE	PUT IN	PULLED OUT
				8-5/8"	270'	None

Describe in detail the manner in which the well was plugged, indicating where the mud fluid was placed and the method or methods used in introducing it into the hole. If cement or other plugs were used, state the character of same and depth placed, from _____ feet to _____ feet for each plug set.

1st Plug at 550' with 20 sacks of cement; 2nd Plug at 270' with 20 sacks of cement; Top Plug at 40' with 10 sacks of cement.
Cement was pumped thru drill pipe with pump truck.

RECEIVED
STATE CORPORATION COMMISSION

NOV 7 1966

CONSERVATION DIVISION
Wichita, Kansas

(If additional description is necessary, use BACK of this sheet)

Name of Plugging Contractor Abercrombie Drilling, Inc.
Address 801 Union Center, Wichita, Kansas

STATE OF KANSAS, COUNTY OF SEDCWICK, ss.
Jack K. Wharton (employee of owner) or (owner/operator) of the above-described well, being first duly sworn on oath, says: That I have knowledge of the facts, statements, and matters herein contained and the log of the above-described well as filed and that the same are true and correct. So help me God.

(Signature) Jack K. Wharton
801 Union Center, Wichita, Kansas
(Address)

SUBSCRIBED AND SWORN to before me this 3rd day of November, 19 66

My commission expires March 31, 1970

Marge Bee Montgomery
Marge Bee Montgomery Notary Public.

CONTRACTOR'S WELL LOG

COMPANY: Abercrombie Drilling, Inc.
 CONTRACTOR: Abercrombie Drilling, Inc.
 FARM: ETHEL MOORE #1
 LOCATION: SE SE SE, Section 26-14S-21W
 Trego County, Kansas
 COMMENCED: October 22, 1966
 COMPLETED: November 2, 1966

0	30	Clay & Sand
30	50	Rock
50	275	Shale & Shells
275	1015	Clay & Shale
1015	1140	Sand
1140	1225	Shale
1225	1275	Red bed
1275	1416	Shale
1416	1463	Anhydrite
1463	2000	Shale
2000	2165	Shale & Lime
2165	2939	Lime & Shale
2939	3009	Shale & Lime
3009	3295	Lime & Shale
3295	3388	Lime
3388	3456	Lime with Shale
3456	3779	Lime
3779	3800	Lime & Chert
3800	3883	Lime & Shale

RECEIVED
 STATE CORPORATION COMMISSION
 NOV 7 1966
 CONSERVATION DIVISION
 Wichita, Kansas

Set 8-5/8" surface casing at 270 feet with 185 sacks of cement.

Dry and Abandoned.

ELEVATION:
 2088 K.B.
 2087 D.F.
 2081 G.L.

ELECTRIC LOG TOPS

Heebner	3382	(-1294)
Toronto	3403	(-1315)
Lansing	3421	(-1333)
Base/K.C.	3670	(-1582)
Cherokee Shale	3800	(-1712)
Arbuckle	3864	(-1776)
Total Depth	3883	(-1795)

STATE OF KANSAS)
) SS
 COUNTY OF SEDGWICK)

I, Jack K. Wharton, do hereby certify that the above and foregoing is a true and correct copy of the log of the Ethel Moore #1, SE SE SE, Section 26-14S-21W, Trego County, Kansas, as reflected by the files of Abercrombie Drilling, Inc.

Jack K. Wharton
 Jack K. Wharton

Subscribed and sworn to before me, a Notary Public, in and for Sedgwick County, Kansas, this 4th day of November, 1966.

Margo Dee Montgomery
 Margo Dee Montgomery
 Notary Public

My commission expires March 31, 1970.

