


WELL PLUGGING RECORD

Give All Information Completely
Make Required Affidavit
Mail or Deliver Report to:
Conservation Division
State Corporation Commission
212 No. Market
Wichita, Kansas

Trego County, Sec. 23 Twp. 14S Rge. (E) 21 (W)

Location as "NE/CNW/SW" or footage from lines NE SW NE
Lease Owner Rains & Williamson Oil Co.
Lease Name Dinkel Well No. 1
Office Address 1425 Wichita Plaza Bldg., Wichita, Kansas
Character of Well (completed as Oil, Gas or Dry Hole) Dry Hole
Date well completed 8-12 19 66
Application for plugging filed 8-12 19 66
Application for plugging approved 8-12 19 66
Plugging commenced 8-12 19 66
Plugging completed 8-12 19 66
Reason for abandonment of well or producing formation no oil or gas found in commercial quantities.
If a producing well is abandoned, date of last production 19
Was permission obtained from the Conservation Division or its agents before plugging was commenced? yes

NORTH

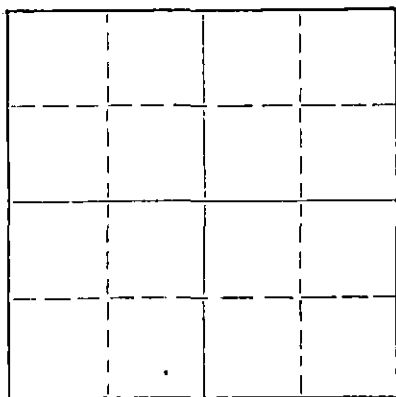

Locate well correctly on above Section Plat

Name of Conservation Agent who supervised plugging of this well Bill Nichols, Mereland, Kansas
Producing formation _____ Depth to top _____ Bottom _____ Total Depth of Well 4010 Feet
Show depth and thickness of all water, oil and gas formations.

OIL, GAS OR WATER RECORDS

CASING RECORD

FORMATION	CONTENT	FROM	TO	SIZE	PUT IN	PULLED OUT
				8-5/8"	237.40'	

Describe in detail the manner in which the well was plugged, indicating where the mud fluid was placed and the method or methods used in introducing it into the hole. If cement or other plugs were used, state the character of same and depth placed, from _____ feet to _____ feet for each plug set.

Pushed plug to 540' and spot with 25 sacks cement. Mud back to 240' placed plug and spot with 25 sacks. Mud back to 10', set solid bridge and capped with 10 sacks.

RECEIVED
STATE CORPORATION COMMISSION
AUG 17 1966

CONSERVATION DIVISION
Wichita, Kansas

(If additional description is necessary, use BACK of this sheet)

Name of Plugging Contractor Rains & Williamson Oil Co.,
Address 1425 Wichita Plaza Bldg., Wichita, Kansas

STATE OF Kansas, COUNTY OF Sedgwick, ss.
Wilson Rains, Partner (employee of owner) or (owner or operator) of the above-described well, being first duly sworn on oath, says: That I have knowledge of the facts, statements, and matters herein contained and the log of the above-described well as filed and that the same are true and correct. So help me God.

(Signature) Wilson Rains
Wilson Rains
1425 Wichita Plaza Bldg., Wichita, Kansas
(Address)

SUBSCRIBED AND SWORN TO before me this 15th day of August, 1966

Mary J. Brown
Mary J. Brown
Notary Public.

My commission expires 3-3-70

ROTARY DRILLING LOG

Operator: Rains & Williamson Oil Co. Contractor: Rains & Williamson Oil Co.
 #1 Dinkel Commenced: 8-3-66
 NE SW NE Sec. 23-14S-21W Completed: 8-12-66
 Trego County, Kansas Remarks: Set 237.40' of 8-5/8" surface pipe with 165 sacks GL3.

Formations

Clay & Post Rock	60'
Shale	1020'
D. Sand	1254'
Red Bed	1577'
Anhydrite	1620'
Shale & Shells	1900'
Shale & Lime	2148'
Shale W/Lime	2370'
Lime & Shale	2670'
Lime w/Shale	2880'
Lime & Shale	3150'
Lime w/Shale	3430'
Lime	3890'
Lime w/Chert	3939'
Marmation Chert w/Lime	3963'
Chert & Lime	3976'
Arbuckle	4010'
Rotary Total Depth (D&A)	4010'

RECEIVED
 STATE CORPORATION COMMISSION
 AUG 17 1966
 CONFIRMATION DIVISION
 Wichita, Kansas

We certify the above log is true and correct to the best of our knowledge and belief.

RAINS & WILLIAMSON OIL CO.

Wilson Rains
 Wilson Rains, Partner

Subscribed and sworn to before me, a Notary Public in and for the State of Kansas, County of Sedgwick, this 15th day of August, 1966

My Commission Expires:
 3-3-70

Mary J. Brown
 Mary J. Brown Notary Public