

STATE OF KANSAS
STATE CORPORATION COMMISSION

Form CP-4


Give All Information Completely
Make Required Affidavit
Mail or Deliver Report to:
Conservation Division
State Corporation Commission
212 No. Market
Wichita, Kansas

WELL PLUGGING RECORD

Trego County, Sec. 11 Twp. 14S Rge. (E) 21W (W)

Location as "NE/CNW/SW" or footage from lines G NW SW
Lease Owner Pickrell Drilling Company
Lease Name Glemens "A" Well No. 1
Office Address 705 Fourth National Bank Bldg., Wichita, Kansas
Character of Well (completed as Oil, Gas or Dry Hole) Dry Hole
Date well completed October 25, 1966
Application for plugging filed October 25, 1966
Application for plugging approved October 25, 1966
Plugging commenced October 25, 1966
Plugging completed October 25, 1966
Reason for abandonment of well or producing formation Dry Hole

NORTH

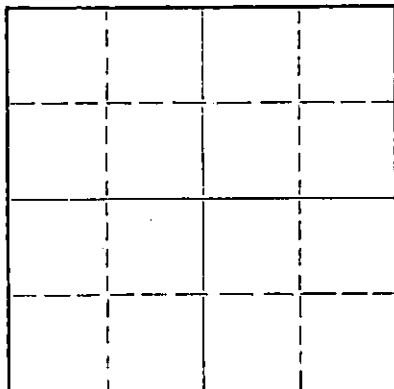

Locate well correctly on above
Section Plat

If a producing well is abandoned, date of last production _____ 19____
Was permission obtained from the Conservation Division or its agents before plugging was commenced? Yes

Name of Conservation Agent who supervised plugging of this well W. L. Nichols, Moreland, Kansas

Producing formation _____ Depth to top _____ Bottom _____ Total Depth of Well 4047 Feet

Show depth and thickness of all water, oil and gas formations.


OIL, GAS OR WATER RECORDS

CASING RECORD

FORMATION	CONTENT	FROM	TO	SIZE	PUT IN	PULLED OUT
				8 5/8"	249'	None

Describe in detail the manner in which the well was plugged, indicating where the mud fluid was placed and the method or methods used in introducing it into the hole. If cement or other plugs were used, state the character of same and depth placed, from _____ feet to _____ feet for each plug set.

Heavy mud to 600'. Set plug. Cemented with
25 sacks cement. Heavy mud to 240'. Set plug.
Cemented with 20 sacks cement. Heavy mud to 40'.
Set plug. Cemented with 10 sacks cement to bottom
of cellar. Plugged rat hole with 2 sacks cement.

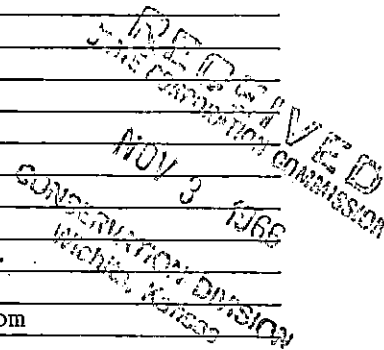

(If additional description is necessary, use BACK of this sheet)


Name of Plugging Contractor Pickrell Drilling Company
Address 705 Fourth National Bank Bldg., Wichita, Kansas

STATE OF KANSAS, COUNTY OF SEDGWICK, ss.

G. W. Sebitts (owner or operator) of the above-described well, being first duly sworn on oath, says: That I have knowledge of the facts, statements and matters herein contained and the log of the above-described well as filed and that the same are true and correct. So help me God.

(Signature) G. W. Sebitts
705 Fourth National Bank Bldg., Wichita, Ks.
(Address)

Subscribed and sworn to before me this 1st day of November, 1966

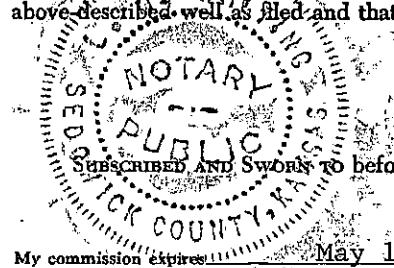

L. M. Whiting
L. M. Whiting
Notary Public.

ROTARY DRILLING LOG

COMPANY: Pickrell Drilling Company
705 Fourth National Bank Bldg.
Wichita, Kansas

Rotary Drilling Commenced 10-15-66

Rotary Drilling Completed 10-25-66

LOCATION: No. 1 Clemens "A"
C NW SW Section 11-14S-21W
Trego County, Kansas

CONTRACTOR: **PICKRELL DRILLING COMPANY**
Wichita, Kansas

CASING RECORD: (9 jts.) 8 5/8" surface casing set at 249' and cemented with 165 sacks cement. Circulated. Completed 4:30 PM October 15, 1966. No oil string run. D. & A. October 25, 1966.

LOG

(Figures indicate bottom of formation — measurements from top of rotary bushing.)

150	Post Rock	<u>G. F. S.</u>
249	Shale & Shells	3560
1325	Shale & Sand	3603
1650	Anhydrite	3652
1720	Shale & Shells	3676
2740	Lime & Shale	3874
2950	Shale	3931
3652	Lime & Shale	3960
3676	Lime	3968
3683	Kansas City Lime & Shale	3975
3735	Lime	3982
3931	Lime & Shale	3987
3968	Lime	3991
3987	Conglomerate	3998
4012	Shale & Lime	4005
4030	Lime	4012
4047	Arbuckle (R.T.D.)	4022
		4030
		4047

RECEIVED
STATE CORPORATION COMMISSION
NOV 8 1966
WICHITA, KANSAS

Slope Tests

- 2000
- 2500
- 3000
- 3500
- 4000

S. L. M.

3510

The undersigned, C. W. Sebitts, Attorney-in-Fact for PICKRELL DRILLING COMPANY, hereby certifies in behalf of said Company, that the above is a true and correct log of the formation encountered in drilling the above well as reflected by the Daily Drilling Reports.

PICKRELL DRILLING COMPANY

By C. W. Sebitts Attorney-in-Fact

STATE OF KANSAS }
COUNTY OF SEDGWICK } ss.:

On this 1st day of November, 1966, before me the undersigned, a Notary Public, in and for the County and State aforesaid, personally appeared G. W. Sebitts, to me known to be the identical person who subscribed the name of PICKRELL DRILLING COMPANY to the foregoing instrument as its Attorney-in-Fact and acknowledged to me that he executed the same as his free and voluntary act and deed, and as the free and voluntary act and deed of such company, for the uses and purposes therein set forth.

Given under my hand and seal of office the day and year last above written.

My commission expires May 10, 1970

L. M. Whiting
L. M. Whiting, Notary Public

