


Give All Information Completely
Make Required Affidavit
Mail or Deliver Report to:
Conservation Division
State Corporation Commission
211 No. Broadway
Wichita, Kansas

WELL PLUGGING RECORD

NORTH

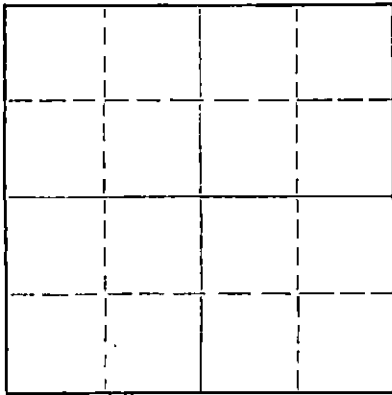

Locate well correctly on above
Section Plot

Trego County. Sec. 9 Twp. 13 Rge. 21 (E) (W) X
Location as "NE/CNW%SW%" or footage from lines. NW SW NW
Lease Owner. Leo J. Dreiling Oil Company
Lease Name Tipton Well No. 1
Office Address Victoria, Kansas
Character of Well (completed as Oil, Gas or Dry Hole) D. & A.
Date well completed 8/26/64 19
Application for plugging filed 8/26/64 19
Application for plugging approved 8/26/64 19
Plugging commenced 8/26/64 19
Plugging completed 8/26/64 19
Reason for abandonment of well or producing formation -0-

If a producing well is abandoned, date of last production -0- 19
Was permission obtained from the Conservation Division or its agents before plugging was commenced? Yes

Name of Conservation Agent who supervised plugging of this well W. L. Nicholas
Producing formation -0- Depth to top -0- Bottom -0- Total Depth of Well 3986' Feet
Show depth and thickness of all water, oil and gas formations.

OIL, GAS OR WATER RECORDS

CASING RECORD

FORMATION	CONTENT	FROM	TO	SIZE	PUT IN	PULLED OUT
Surface Pipe				8 5/8"	192'	-0-

Describe in detail the manner in which the well was plugged, indicating where the mud fluid was placed and the method or methods used in introducing it into the hole. If cement or other plugs were used, state the character of same and depth placed, from _____ feet to _____ feet for each plug set.
Rotary mud was used to fill hole to a depth of 540' were 1st plug was set using 20 sacks cement, filling hole to a depth of 180' were 2nd plug was set using 20 sacks cement, filling hole to a depth of 40' were 3rd plug was set using 10 sacks cement and filling hole to surface.

(If additional description is necessary, use BACK of this sheet)

Name of Plugging Contractor L. J. Dreiling & Sons, Inc.
Address Victoria, Kansas

STATE OF Kansas, COUNTY OF Ellis, ss.

I, Leo F. Dreiling a partner (employee or owner or operator) of the above-described well, being first duly sworn on oath, says: That I have knowledge of the facts, statements, and matters herein contained and the log of the above-described well as filed and that the same are true and correct. So help me God.

(Signature) Leo F. Dreiling
Leo F. Dreiling

SUBSCRIBED AND SWORN TO before me this 12th day of September, 19 64

Ronald Zimmerman
Notary Public.

My commission expires August 14, 1965

L. J. DREILING and SONS, Inc.

VICTORIA, KANSAS

WELL LOG

Company Leo J. Dreiling Oil Company
Victoria, Kansas

Sec. 9 Twp. 13 Rng. 21

Farm Tipton No. 1

Location NW SW NW

Total Depth 3986'

County Trego County, Kansas

Comm. 8/17/64 Comp. 8/26/64

Elevation: D. F.

Contractor L. J. DREILING AND SONS, INC.
VICTORIA, KANSAS

G. R.

Casing Record

Cement Record

Production:

192' - - - 8 5/8"

150 sacks cement

D. & A.

Figures Indicate Bottom of Formations

0 - 50	Surface Clay
50 - 190	Clay & Shale
190 - 1190	Shale
1190 - 1630	Shale
1630 - 1676	Anhydrite
1676 - 1815	Red Bed
1815 - 2254	Shale & Shells
2254 - 2459	Lime & Shale
2459 - 2604	Lime & Shale
2604 - 2822	Shale & Lime
2822 - 2968	Shale & Lime
2968 - 3132	Lime & Shale
3132 - 3291	Shale & Lime
3291 - 3388	Lime
3388 - 3473	Lime
3473 - 3532	Lime
3532 - 3594	Lime
3594 - 3634	Lime
3634 - 3698	Lime
3698 - 3731	Lime
3731 - 3831	Lime
3831 - 3885	Lime
3885 - 3912	Lime
3912 - 3950	Lime
3950 - 3986	Lime
3986	TD

State of Kansas)
) ss.
COUNTY OF ELLIS)

I, Leo F. Dreiling of the L. J. Dreiling and Sons, Inc., upon oath states that the above and foregoing is a true and correct copy from the Daily Drilling Report from your Tipton #1.

Leo F. Dreiling
LEO F. DREILING

Subscribed and sworn to before me this 12th day of September, 1964.

Robert Zimmerman
NOTARY PUBLIC

My Commission Expires: August 11, 1965