

15.195.20563.00.00

STATE OF KANSAS  
STATE CORPORATION COMMISSION

WELL PLUGGING RECORD

Give All Information Completely  
Make Required Affidavit  
Mail or Deliver Report to  
Conservation Division,  
State Corporation Comm.,  
245 North Water  
Wichita, KS 67202

Trego County, Sec. 2 Twp. 12S Rge. 25 ~~NE~~W  
Location as "NE/CNW/SW" or footage from lines  
NW SE SW

Lease Owner Liberty Enterprises, Inc.

Lease Name Lipp Well No. #1

Office Address 308 West Mill Plainville, Ks. 67663

Character of Well (Completed as Oil, Gas or Dry Hole)  
Dry Hole

Date Well completed July 14 1979

Application for plugging filed July 14 1979

Application for plugging approved July 14 1979

Plugging commenced July 14 10:30 A.M. 1979

Plugging completed July 14 12:00 A.M. 1979

Reason for abandonment of well or producing formation

No Commercial Production

If a producing well is abandoned, date of last production


19

Was permission obtained from the Conservation Division or  
its agents before plugging was commenced? yes

Name of Conservation Agent who supervised plugging of this well Gil Balthazor

Producing formation \_\_\_\_\_ Depth to top \_\_\_\_\_ Bottom \_\_\_\_\_ Total Depth of Well \_\_\_\_\_

Show depth and thickness of all water, oil and gas formations.

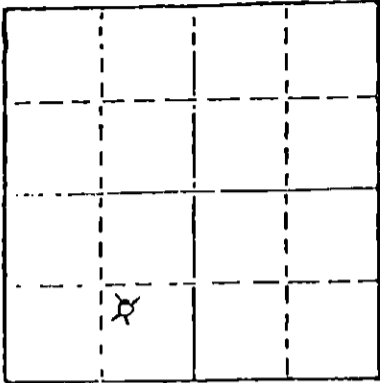

Locate well correctly on above  
Section Plot

OIL, GAS OR WATER RECORDS

CASING RECORD

FORMATION	CONTENT	FROM	TO	SIZE	PUT IN	PULLED OUT
surface casing	common	0	198.86'	8 5/8"	198.86'	0

Describe in detail the manner in which the well was plugged, indicating where the mud fluid  
was placed and the method or methods used in introducing it into the hold. If cement or other  
plugs were used, state the character of same and depth placed, from \_\_\_\_\_ feet to  
\_\_\_\_\_ feet for each plug set.

Plug #1 @ 1000' with 70 sxs

Plug #2 @ 190' with 20 sxs

Plug #3 @ 40' with solid bridge and 40 sxs wooden blue

Plugged rathole with 33 sxs

Total 103 sxs 50-50 poz 6% gel

RECEIVED  
STATE CORPORATION COMMISSION

(If additional description is necessary, use BACK of this sheet)

Name of Plugging Contractor Pioneer Drilling Company, Inc.  
308 West Mill Plainville, Kansas 67663

STATE OF Kansas COUNTY OF Rooks, ss.  
Charles G. Comeau (employee of owner) or (owner or operator


of the above-described well, being first duly sworn on oath, says: That I have knowledge of  
the facts, statements, and matters herein contained and the log of the above-described well  
as filed and that the same are true and correct. So help me God.

(Signature) Charles G. Comeau  
308 West Mill Plainville, Ks. 67663  
(Address)

SUBSCRIBED AND SWORN TO before me this 19th day of July, 1979

Connie Jo Austin  
Notary Public.

My commission expires \_\_\_\_\_

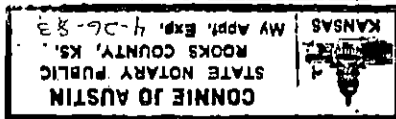

WELL LOG

OPERATOR: Liberty Enterprises, Inc.

WELL NAME: Lipp #1 LOCATION: NW SE SW 2-12S-25W

COUNTY: Trego STATE: Kansas

WELL COMMENCED: July 5, 1979 WELL COMPLETED: July 14, 1979

ELEVATION: 2571' KB TOTAL DEPTH: 4170'

PRODUCTION: D & A RIG NO: #1

CASING - 8-5/8": 198.86' of 28# cemented with 140 sxs common 2% gel 3% cc  
5-1/2": none

ALL MEASUREMENTS TAKEN FROM THE TOP OF ROTARY BUSHING:

FROM	TO	FORMATION	DEVIATION FROM VERTICAL	REMARKS:
0'	207'	sands and shales	175' - 3/4 degree	
207'	207'	sand and shale		
207'	535'	shale and sand		
535'	1800'	sands and shales		
1800'	2165'	sand and shale		
2165'	2175'	Anhydrite		
2175'	2500'	shale and shells		
2500'	2695'	shales and limes	2647' - 3/4 degree	
2695'	2886'	shale and lime		
2886'	3125'	lime and shale		
3125'	3300'	shales and limes		
3300'	3432'	shale and lime		
3432'	3555'	lime and shale		
3555'	3640'	lime and shale		
3640'	3742'	lime and shale		
3742'	3822'	shale and lime		
3822'	3888'	lime and shale		
3888'	3957'	lime and shale		
3957'	4015'	lime		
4015'	4075'	lime		
4075'	4100'	lime	4100' - 1/2 degree	
4100'	4100'	l		
4100'	4122'	lime		
4122'	4125'	lime		
4125'	4130'	lime		
4130'	4170'	lime		
4170'	4170'	lime		
4170'	RTD			

STATE OF KANSAS  
 COUNTY OF


The undersigned hereby certifies that to the best of his knowledge and belief, the above facts are true and correct

PIONEER DRILLING CO., INC.

By Charles Homan

SUBSCRIBED AND SWORN TO, BEFORE ME, This 19th day of July, 1979.

Connie Jo Austin  
 -NOTARY PUBLIC

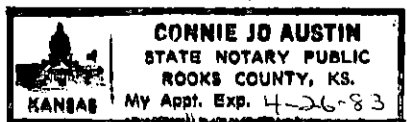

RECEIVED  
 STATE CORPORATION COMMISSION  
 JUL 20 1979  
 CONSERVATION DIVISION  
 Wichita, Kansas