


STATE OF KANSAS  
STATE CORPORATION COMMISSION

WELL PLUGGING RECORD

Give All Information Completely  
Make Required Affidavit  
Mail or Deliver Report to:  
Conservation Division  
State Corporation Commission  
211 No. Broadway  
Wichita, Kansas

Trego County. Sec. 2 Twp. 12S Rge. 23W (E) (W)  
Location as "NE/CNW%SW%" or footage from lines C E 1/2 NE SW  
Lease Owner Imperial Oil of Kansas, Inc.  
Lease Name Hixson "D" Well No. 5  
Office Address Wichita, Kansas  
Character of Well (completed as Oil, Gas or Dry Hole) Dry Hole  
Date well completed March 27, 1957  
Application for plugging filed March 27, 1957  
Application for plugging approved March 27, 1957  
Plugging commenced March 27, 1957  
Plugging completed March 27, 1957  
Reason for abandonment of well or producing formation No commercial quantities of oil found.  
If a producing well is abandoned, date of last production \_\_\_\_\_ 19\_\_\_\_  
Was permission obtained from the Conservation Division or its agents before plugging was commenced? Yes

NORTH

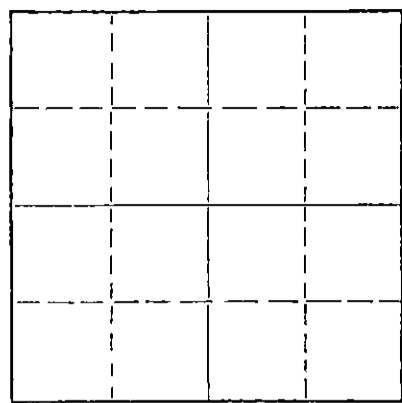

Locate well correctly on above Section Flat

Name of Conservation Agent who supervised plugging of this well Eldon Petty, Hays, Kansas  
Producing formation \_\_\_\_\_ Depth to top \_\_\_\_\_ Bottom \_\_\_\_\_ Total Depth of Well 3915 Feet  
Show depth and thickness of all water, oil and gas formations.

OIL, GAS OR WATER RECORDS

CASING RECORD

| FORMATION | CONTENT | FROM | TO | SIZE   | PUT IN  | PULLED OUT |
|-----------|---------|------|----|--------|---------|------------|
|           |         |      |    | 8-5/8" | 3-27-57 |            |
|           |         |      |    |        |         |            |
|           |         |      |    |        |         |            |
Describe in detail the manner in which the well was plugged, indicating where the mud fluid was placed and the method or methods used in introducing it into the hole. If cement or other plugs were used, state the character of same and depth placed, from \_\_\_\_\_ feet to \_\_\_\_\_ feet for each plug set.

Set No. 1 plug at 180 feet with 1/2 sack hulls and 15 sacks cement.  
Set No. 2 plug at 40 feet with 1/2 sack hulls and 10 sacks cement.

RECEIVED 4-6-1957  
STATE CORPORATION COMMISSION

(If additional description is necessary, use BACK of this sheet)  
Name of Plugging Contractor Imperial Oil of Kansas, Inc.  
Address 903 Union National Building, Wichita 2, Kansas

STATE OF KANSAS COUNTY OF SEDGWICK, ss.  
Raymond L. Bacon (employee of owner) or (owner or operator) of the above-described well, being first duly sworn on oath, says: That I have knowledge of the facts, statements, and matters herein contained and the log of the above-described well as filed and that the same are true and correct. So help me God.

By: Raymond L. Bacon V-P  
903 Union National Bldg., Wichita 2, Kansas  
(Address)

SUBSCRIBED AND SWORN TO before me this 5th day of April, 1957

Louetta M. Duncan  
Louetta M. Duncan Notary Public.

My commission expires December 19, 1960

PLUGGING  
FILE SEC. 2 T. 12 R. 23w  
BOOK PAGE 2 LINE 42

DRILLER'S LOG

Imperial Oil of Kansas, Inc.  
 903 Union National Building  
 Wichita 2, Kansas

Hixson "D" No. 5  
 CE $\frac{1}{2}$  NE SW Sec. 2-12S-23W  
 Trego County, Kansas

Total Depth: 3915'

Elevation: 2430' R.B.  
 Production: D & A

Commenced: 3-15-57 Completed: 3-27-57

Contractor: Imperial Oil of Kansas, Inc.  
 Wichita, Kansas

Casing Record: Set 8-5/8" Surface Pipe at 184' with 150 sacks cement.

Figures indicate bottom of formations:

|                |       |             |                 |
|----------------|-------|-------------|-----------------|
| Shale & Sand   | 184'  |             |                 |
| Shale & Shells | 1848' |             |                 |
| Anhydrite      | 1897' | Anhydrite   | 1848' ( / 582 ) |
| Shale & Shells | 2425' | Heebner     | 3642' ( -1212 ) |
| Lime & Shale   | 3672' | Toronto     | 3662' ( -1232 ) |
| Lime           | 3915' | Lansing     | 3675' ( -1245 ) |
| Total Depth    | 3915' | Total Depth | 3915' ( -1485 ) |

We hereby certify this to be a correct and accurate log of the above described well as shown on the daily drilling reports.

IMPERIAL OIL OF KANSAS, INC.

**RECEIVED**  
 STATE CORPORATION COMMISSION

By: *Alan D. ...*  
 Vice-President

APR 6 - 1957

Subscribed and sworn to before me on this 5th day of April, 1957.  
 ...a. Kansas

My Commission Expires:

December 19, 1960

*Loretta M. ...*  
 Notary Public

**PLUGGING**  
 FILE SEC. 2 T. 12 R. 23W  
 BOOK PAGE 2 LINE 42