

STATE OF KANSAS
STATE CORPORATION COMMISSION


WELL PLUGGING RECORD
OR
FORMATION PLUGGING RECORD

Strike out upper line
when reporting plug-
ging off formations.

Give All Information Completely
Make Required Affidavit
Mail or Deliver Report to:
Conservation Division
State Corporation Commission,
800 Bitting Building,
Wichita, Kansas

TREGO County. Sec. 2 Twp. 12 Rge. (E) 22 (W)

Location as "NE¹/₄NW¹/₄SW¹/₄" or footage from lines... NE NE NE
Lease Owner THE OHIO OIL COMPANY
Lease Name JOHN KELSCH Well No. 1
Office Address Box 710, McPherson, Kansas
Character of Well (Completed as Oil, Gas or Dry Hole) Dry Hole
Date, well completed June 30, 1945 19
Application for plugging filed June 30, 1945 193
Application for plugging approved (verbal) June 30, 1945 193
Plugging Commenced June 30, 1945 193
Plugging Completed June 30, 1945 193
Reason for abandonment of well or producing formation Dry Hole

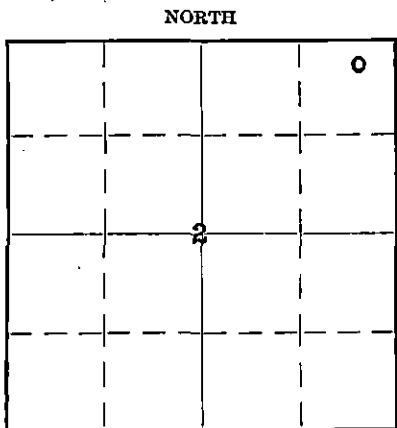

Locate well correctly on above
Section Plat

If a producing well is abandoned, date of last production 193
Was permission obtained from the Conservation Division or its agents before plugging was com-
menced? Yes

Name of Conservation Agent who supervised plugging of this well Mr. H. W. Kerr
Producing formation Depth to top Bottom Total Depth of Well 4174 Feet

Show depth and thickness of all water, oil and gas formations.

OIL, GAS OR WATER RECORDS

CASING RECORD

Formation	Content	From	To	Size	Put In	Pulled Out
Arbuckle	Water	4046	4174	10 3/4"	1017'	None

Describe in detail the manner in which the well was plugged, indicating where the mud fluid was placed and the method or methods used in introducing it into the hole. If cement or other plugs were used, state the character of same and depth placed, from...feet to...feet for each plug set.

Set bottom plug @ 450'. Heavy mud from 4174 to 450'. Cement plug from 450' to 410' (20 sx).
Heavy mud from 410' to 18'. Set plug at 18'. Cemented with 10 sacks to surface.

2 12 22W
19 20

(If additional description is necessary use BACK of this sheet)

Correspondence regarding this well should be addressed to The Ohio Oil Company
Address Box 710, McPherson, Kansas

STATE OF KANSAS, COUNTY OF MCPHERSON, ss.
FRED V. KLUCK (employee of owner) or (owner or operator) of the above-described well,
being first duly sworn on oath, says: That I have knowledge of the facts, statements, and matters herein contained and the log of the above-described well as filed and that the same are true and correct. So help me God.

(Signature) Fred V. Kluck
Box 710, McPherson, Kansas
(Address)

SUBSCRIBED AND SWORN to before me this 5th day of July, 1945

My Commission Expires Nov. 13, 1948

My commission expires

Notary Public.

7-6-1945

THE OHIO OIL COMPANY
 JOHN KELSCH NO. 1
 NE NE₄NE Sec. 2-12-22W
 TREGO COUNTY, KANSAS

CONTRACTOR: THE VEEDER SUPPLY & DEVELOPMENT CO.
 COMMENCED: June 1, 1945
 COMPLETED: June 30, 1945
 TOTAL DEPTH: 4174 ft.
 DRY & ABANDONED

CASING RECORD:
 10³/₄" cemented @ 1017 ft. with 450 sx. (cement circ. to surface)

0-310	Sand
310-350	Shale, gray, soft
350-430	Shale, blue & shells
430-500	Shale, blue, soft
500-660	Shale, gray
660-775	Shale & pyrite
775-940	Sand
940-1010	Sand & pyrite
1010-1017	Red bed & pyrite
1017-1160	Shale, blue & shells
1160-1335	Shale & shells
1335-1550	Sand
1550-1705	Red rock & shale
1705-1820	" " " "
1820-1845	Anhydrite
1845-1855	Red bed & shale
1855-1980	Red bed, lime, shale & shells
1980-2070	Shale & red rock
2070-2195	Lime & shale
2195-2225	Salt
2225-2335	Shale
2335-2405	Lime
2405-2535	Lime & shale
2535-2810	Lime
2810-3055	Shale & shells
3055-3430	Lime & shale
3430-3475	Lime
3475-3515	Lime & Shale
3515-3570	Lime
3570-3745	Lime & Shale
3745-3765	Lime
3765-3860	Lime & Shale
3860-3900	Lime
3900-3965	Lime & Shale
3965-3990	Lime
3990-4010	Chert & Shale
4010-4040	Lime
4040-4055	Shale & Lime
4046-4056	Dolomite & Lime
4056-4064	Dolomite (Cored)
4064-4100	Lime & Dolomite DST 1800' salt water in 30 min.
4100-4174	Lime & Dolomite
4174	TD D&A

PLUGGING
 FILE 15-195-12R22W
 BOOK PAGE-19 LINE 2.0

STATE OF KANSAS
 COMMISSIONER
 JUL 6 - 1945
 STATE OF KANSAS