


Give All Information Completely
Make Required Affidavit
Mail or Deliver Report to:
Conservation Division
State Corporation Commission
211 No. Broadway
Wichita, Kansas

WELL PLUGGING RECORD

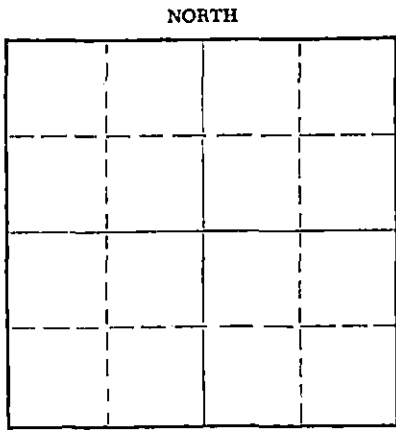

Locate well correctly on above Section Plat

Trego County, Sec. 35 Twp. 12S Rge. 21W (E) (W)
Location as "NE/CNW/SW" or footage from lines C NW SW
Lease Owner Gross and Dunne-Gardner Petroleum, Inc.
Lease Name Helget Well No. 1
Office Address 300 Schweiter Building, Wichita, Kansas
Character of Well (completed as Oil, Gas or Dry Hole) Dry Hole
Date well completed 12-12 19 66
Application for plugging filed 12-12 19 66
Application for plugging approved 12-12 19 66
Plugging commenced 12-12 19 66
Plugging completed 12-12 19 66
Reason for abandonment of well or producing formation Dry Hole

If a producing well is abandoned, date of last production 19
Was permission obtained from the Conservation Division or its agents before plugging was commenced? yes

Name of Conservation Agent who supervised plugging of this well Bill Nichols
Producing formation Depth to top Bottom Total Depth of Well 3885 Feet
Show depth and thickness of all water, oil and gas formations.

OIL, GAS OR WATER RECORDS

CASING RECORD

FORMATION	CONTENT	FROM	TO	SIZE	PUT IN	PULLED OUT
				8-5/8"	130'	None

Describe in detail the manner in which the well was plugged, indicating where the mud fluid was placed and the method or methods used in introducing it into the hole. If cement or other plugs were used, state the character of same and depth placed, from feet to feet for each plug set.

Mud to 600', set plug, 1/4 sack hulls, 25 sacks cement
Mud to 120', set plug, 1/4 sack hulls, 20 sacks cement
Mud to 40', set plug, 1/4 sack hulls, 10 sacks cement
2 sacks cement in rathole

12-14-1966
RECEIVED
STATE CORPORATION COMMISSION
DEC 14 1966
CONSERVATION DIVISION
Wichita, Kansas

(If additional description is necessary, use BACK of this sheet)

Name of Plugging Contractor Dunne-Gardner Petroleum, Inc.
Address 300 Schweiter Building, Wichita, Kansas

STATE OF KANSAS, COUNTY OF SEDGWICK, ss.

Don Gardner (employer/owner) or (owner or operator) of the above-described well, being first duly sworn on oath, says: That I have knowledge of the facts, statements, and matters herein contained and the log of the above-described well as filed and that the same are true and correct. So help me God.

(Signature) *[Signature]*
300 Schweiter Building, Wichita, Kansas
(Address)

SUBSCRIBED AND SWORN TO before me this 12th day of December, 19 66

My commission expires December 14, 1969

[Signature]
Notary Public.

DRILLER'S LOG

OPERATOR: W. R. Gross & Dunne-Gardner Petroleum, Inc.
 300 Schweiter Building, Wichita, Kansas

CONTRACTOR: Dunne-Gardner Petroleum, Inc.
 300 Schweiter Building, Wichita, Kansas

LEASE: Helget

WELL: No. 1

LOCATION: C NW SW Section 35-12S-21W
 Trego County, Kansas

COMMENCED: December 2, 1966

COMPLETED: December 12, 1966


CASING RECORD: 8-5/8" @ 130' w/125 sacks cement

<u>FROM</u>	<u>TO</u>	
0	130	Soil, shale and shells
130	900	Shale and sand
900	1050	Shale and Red Bed
1050	1245	Sand
1245	1533	Shale and shells
1533	1575	Anhydrite
1575	1926	Shale and shells
1926	3392	Lime and shale
3392	3819	Lime
3819	3877	Lime and chert
3877	3885	Lime
3885		Rotary Total Depth

RECEIVED
 STATE CORPORATION COMMISSION
 DEC 14 1966
 CONSERVATION DIVISION
 WICHITA, KANSAS

I certify the above to be true and correct to the best of my knowledge and belief.

DUNNE-GARDNER PETROLEUM, INC.

By 
 Don Gardner

Subscribed and sworn to before me this 12th day of December, 1966.

My commission expires:
 December 14, 1969


 Notary Public