


15.195.00347.00.00

OF KANSAS
STATE REGISTRATION COMMISSION
STATE CORP.
Give All Information Completely
Make Required Affidavit
Report to:
Mail or Deliver Division
Conservation Commission
State Capitol Building
800 West
Topeka, Kansas

WELL PLUGGING RECORD

Trego County, Sec. 14 Twp. 12S Rge. 21 (E) W (W)
Location as "NE/CNW $\frac{1}{4}$ SW $\frac{1}{4}$ " or footage from lines NW NW NW
Lease Owner Peel-Hardman Oil Producers
Lease Name Cotton Well No. 1
Office Address P. O. Box 359, Holsington, Kansas
Character of Well (completed as Oil, Gas or Dry Hole) Dry Hole
Date well completed Oct. 6 19 51
Application for plugging filed Oct. 6 19 51
Application for plugging approved Oct. 6 19 51
Plugging commenced Oct. 6 19 51
Plugging completed Oct. 6 19 51
Reason for abandonment of well or producing formation Dry Hole

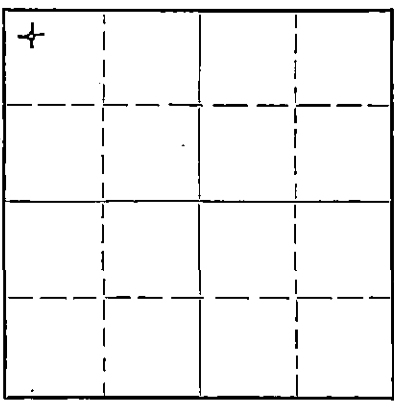

Locate well correctly on above Section Plat

If a producing well is abandoned, date of last production..... 19.....
Was permission obtained from the Conservation Division or its agents before plugging was commenced? Yes

Name of Conservation Agent who supervised plugging of this well E. R. Petty
Producing formation..... Depth to top..... Bottom..... Total Depth of Well 4029 Feet
Show depth and thickness of all water, oil and gas formations.

OIL, GAS OR WATER RECORDS

CASING RECORD

Formation	Content	From	To	Size	Put In	Pulled Out
		0	225'	8 5/8"	225'	None

Describe in detail the manner in which the well was plugged, indicating where the mud fluid was placed and the method or methods used in introducing it into the hole. If cement or other plugs were used, state the character of same and depth placed, from..... feet to..... feet for each plug set.

- 4029' - 221 $\frac{1}{2}$ ' - Heavy Rotary Mud
- 221 $\frac{1}{2}$ ' - 220' - Wooden Plug
- 220' - 174' - 15 sacks cement and $\frac{1}{2}$ sack hulls
- 174' - 41 $\frac{1}{2}$ ' - Heavy Rotary Mud
- 41 $\frac{1}{2}$ ' - 40' - Wooden Plug
- 40' - 6' - $\frac{1}{2}$ sack hulls and 10 sacks cement
- 6' - Surface - Cellar

STATE OF KANSAS
OCT 13 1951
CONSERVATION DIVISION
Topeka, Kansas

(If additional description is necessary, use BACK of this sheet)
Name of Plugging Contractor Peel-Hardman
Address P. O. Box 359, Holsington, Kansas

STATE OF Kansas COUNTY OF Barton, SS.
Peel-Hardman (employee of owner) or (owner) of the above-described well,

being first duly sworn on oath, says: That I have knowledge of the facts, statements, and matters herein contained and the log of the above-described well as filed and that the same are true and correct. So help me God.

BY: Peel-Hardman
(Signature) [Signature]
P. O. Box 359, Holsington, Kansas
(Address)

SUBSCRIBED AND SWORN TO before me this 12th day of October, 19 51

My commission expires June 4, 1955 Manaw M. Herbst Notary Public.

23-8390-s 6-51-20M
FILED OCT 14 1951
BOOK PAGE 15 LINE 13

DRILLER'S LOG

Peel-Hardman Oil Producers
Company: Aurora Gasoline Company

NW NW NW
Sec. 14 Twp. 12S, Rge. 21W

Farm: Cotton Well No. 1
Comm: 9-24-51 Comp: 10-6-51

County: Trego,
Kansas

Total Depth: 4029'
Contractor: Peel-Hardman
Casing:

Elevation:

8 5/8" 225' cem.

Production: Dry

Figures below indicate bottom of formations

Sand, Shale & Shells	0 -	225
Shale		720
Sand & Shale		1495
Shale & Shells		1760
Anhydrite		1800
Shale & Shells		2685
Lime & Shale		2765
Lime		2865
Lime & Shale		2960
Shale & Shells		3165
Shale & Lime		3660
Lime		3935
Lime & Chert		3975
Conglomerate		4010
Lime		4029
Total Depth		4029

This is to certify that the above information is, to the best of our knowledge true and correct.

STATE OF KANSAS
OCT 13 1951
COMMISSIONER OF REVENUE

PEEL-HARDMAN

BY: Wm. Hester

SUBSCRIBED AND SWORN to before me this 12th day of October, 1951.

My commission expires June 4, 1955

Marian M. Hester
Notary Public

PLUGGING
FILE SEC-14T-12R-21W
BOOK PAGE-165 LINE-13