

STATE OF KANSAS
STATE CORPORATION COMMISSION


Give All Information Completely
Make Required Affidavit
Mail or Deliver Report to:
Conservation Division
State Corporation Commission
800 Bittling Building
Wichita, Kansas

WELL PLUGGING RECORD

Trego County, Sec. 10 Twp. 12S Rge. 21W (E) (W)

Location as "NE/CNW/SW" or footage from lines NW SW SE
Lease Owner Davis Brothers
Lease Name Schaeffer Well No. 1
Office Address 14 E. Third, Tulsa, Oklahoma
Character of Well (completed as Oil, Gas or Dry Hole) Dry hole
Date well completed December 23 1952
Application for plugging filed December 23 1952
Application for plugging approved December 23 1952
Plugging commenced 1:00 a.m., December 23 1952
Plugging completed 8:00 a.m., December 23 1952
Reason for abandonment of well or producing formation Commercial quantity of oil not found
If a producing well is abandoned, date of last production 19
Was permission obtained from the Conservation Division or its agents before plugging was commenced? Yes

NORTH

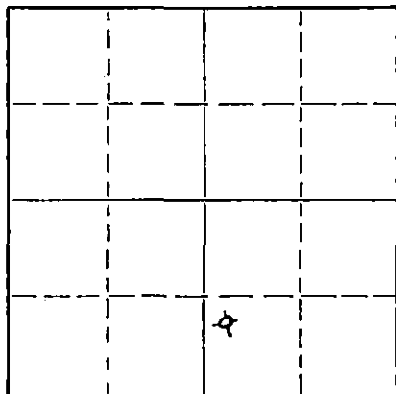

Locate well correctly on above Section Plat

Name of Conservation Agent who supervised plugging of this well Eldon Petty
Producing formation _____ Depth to top _____ Bottom _____ Total Depth of Well _____ Feet
Show depth and thickness of all water, oil and gas formations.

OIL, GAS OR WATER RECORDS

CASING RECORD

FORMATION	CONTENT	FROM	TO	SIZE	PUT IN	PULLED OUT
				8 5/8	210'	

Describe in detail the manner in which the well was plugged, indicating where the mud fluid was placed and the method or methods used in introducing it into the hole. If cement or other plugs were used, state the character of same and depth placed, from _____ feet to _____ feet for each plug set.

Set bottom plug at 190' w/15 sacks cement. Top plug at 40' w/10 sacks cement.

RECEIVED
STATE CORPORATION COMMISSION
DEC 31 1952
CONSERVATION DIVISION
Wichita, Kansas

(If additional description is necessary, use BACK of this sheet)

Name of Plugging Contractor K & E DRILLING, INC.
Address 1006 Central Building, Wichita, Kansas

12-31-1952

STATE OF Kansas COUNTY OF Sedgwick, ss.
Clinton Engstrand, agent for _____ (employee of owner) or (owner or operator) of the above-described well, being first duly sworn on oath, says: That I have knowledge of the facts, statements, and matters herein contained and the log of the above-described well as filed and that the same are true and correct. So help me God.

(Signature) Clinton Engstrand
1006 Central Building, Wichita, Kansas
(Address)

SUBSCRIBED AND SWORN TO before me this 29 day of December, 19 52

My commission expires 10-29-55

Notary Public

PLUGGING
FILE SEC 10 T 12 R 212
BOOK PAGE 48 LINE 40

DAVIS BROTHERS
NO. 1 SCHAEFFER

NW SW SE SEC. 10-12S-21W
TREGO COUNTY, KANSAS

Casing

Cement
125 Sacks

8 5/8 Set @ 210'

Comm: 12-8-52
Comp: 12-23-52
Total Depth: 4047'

FORMATION

DEPTH

Sand and shale	0 - 207
Shale	207 - 740
Sand, shale and shells	740 - 850
Shale and shells (streaks of sand)	850 - 1268
Sand	1268 - 1475
Shale and red bed	1475 - 1778
Anhydrite	1778 - 1823
Shale and shells	1823 - 2309
Shale and lime	2309 - 2455
Lime and shale	2455 - 2560
Lime and shale	2560 - 2638
Lime and shale	2638 - 3390
Lime	3390 - 3698
Lime	3698 - 3883
Lime (Streaks of shale)	3883 - 3910
Lime	3910 - 3960
Cherty lime	3960 - 3980
Lime (Cherty)	3980 - 4004
Shale and chert	4004 - 4033
Lime	4033 - 4047

STATE OF KANSAS)
) SS
SEDGWICK COUNTY)

I hereby certify that the above information is true and correct to the best of my knowledge.

[Signature]

Subscribed and sworn to before me this 29 day of December, 1952.

[Signature]
Notary Public

My Commission Expires: 10-29-55

PLUGGING
FILE SEC 10-12 R 212
BOOK PAGE 68 LINE 40

RECEIVED
STATE CORPORATION COMMISSION
DEC 31 1952
CONSERVATION DIVISION
Wichita, Kansas