

Give All Information Completely  
Make Required Affidavit  
Mail or Deliver Report to:  
Conservation Division  
State Corporation Commission  
211 No. Broadway  
Wichita, Kansas

WELL PLUGGING RECORD

Trego

County, Sec. 16 Twp. 11S Rge. 24W

Location as "NE/CNW/SW" or footage from lines C SE SW

Lease Owner Mayfield-Smith Drilling, Inc., et al

Lease Name Garrett Well No. 1

Office Address 928 Union Center, Wichita, Kansas

Character of Well (completed as Oil, Gas or Dry Hole) Dry Hole

Date well completed August 13 19 63

Application for plugging filed 19 63

Application for plugging approved 19 63

Plugging commenced 19 63


Plugging completed 19 63

Reason for abandonment of well or producing formation

Oil in commercial quantities not found

If a producing well is abandoned, date of last production - - - 19 - - -

Was permission obtained from the Conservation Division or its agents before plugging was commenced? Yes

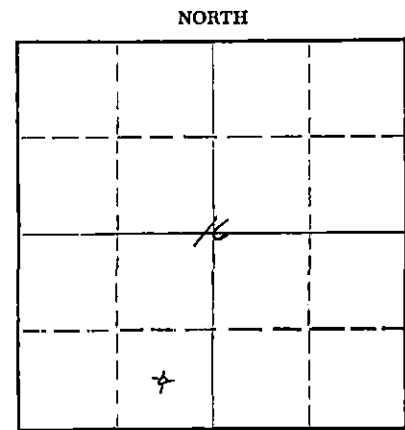

Locate well correctly on above Section Plat

Name of Conservation Agent who supervised plugging of this well Bill Nicholson, Moreland, Kansas

Producing formation - - - Depth to top - - - Bottom - - - Total Depth of Well 4070 Feet

Show depth and thickness of all water, oil and gas formations.

OIL, GAS OR WATER RECORDS

CASING RECORD

FORMATION	CONTENT	FROM	TO	SIZE	PUT IN	PULLED OUT
				8 5/8"	208'	None

Describe in detail the manner in which the well was plugged, indicating where the mud fluid was placed and the method or methods used in introducing it into the hole. If cement or other plugs were used, state the character of same and depth placed, from - - - feet to - - - feet for each plug set.

Filled hole with heavy rotary mud to 600'.  
Set bottom plug with 20 Sks. Cement  
Set #2 plug at 190' with 1/2 Sk. Hulls, 20 Sks. Cement  
Set top plug at 40' with 10 Sks. Cement.

RECEIVED  
STATE CORPORATION COMMISSION

AUG 22 1963

CONSERVATION DIVISION  
Wichita, Kansas

(If additional description is necessary, use BACK of this sheet)  
Name of Plugging Contractor Mayfield-Smith Drilling, Inc.  
Address 928 Union Center Bldg., Wichita 2, Kansas

STATE OF Kansas, COUNTY OF Sedgwick, ss.  
Charles R. Mayfield (employee of owner) or (owner or operator) of the above-described well, being first duly sworn on oath, says: That I have knowledge of the facts, statements, and matters herein contained and the log of the above-described well as filed and that the same are true and correct. So help me God.

(Signature) Charles R. Mayfield  
928 Union Center, Wichita, Kansas  
(Address)

20th day of August, 19 63

Marguerite Mayfield Notary Public.

10-26-65

