


WELL PLUGGING RECORD

Give All Information Completely
Make Required Affidavit
Mail or Deliver Report to:
Conservation Division
State Corporation Commission
212 North Market, Insurance Bldg.
Wichita, Kansas

NORTH

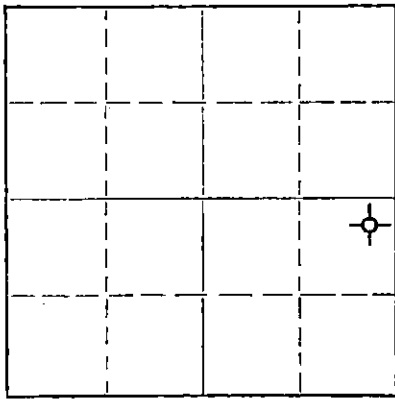

Locate well correctly on above Section Plat

Trego County. Sec. 22 Twp. 11S Rge. 23 (E) W (W)
Location as "NE/CNW/SW" or footage from lines NE NE SE
Lease Owner C-G Drilling Co. & Benedict Oil Associates
Lease Name Hille Well No. 1
Office Address 107 Rule Building, Wichita 2, Kansas
Character of Well (completed as Oil, Gas or Dry Hole) Dry Hole
Date well completed August 13 1961
Application for plugging filed August 13 1961
Application for plugging approved August 13 1961
Plugging commenced August 13 1961
Plugging completed August 13 1961
Reason for abandonment of well or producing formation Too low structurally

If a producing well is abandoned, date of last production _____ 19____
Was permission obtained from the Conservation Division or its agents before plugging was commenced? Yes

Name of Conservation Agent who supervised plugging of this well Eldon Petty, Hays, Kansas
Producing formation _____ Depth to top _____ Bottom _____ Total Depth of Well 3900 Feet
Show depth and thickness of all water, oil and gas formations.

OIL, GAS OR WATER RECORDS

CASING RECORD

FORMATION	CONTENT	FROM	TO	SIZE	PUT IN	PULLED OUT
				8-5/8"	176.76'	None

Describe in detail the manner in which the well was plugged, indicating where the mud fluid was placed and the method or methods used in introducing it into the hole. If cement or other plugs were used, state the character of same and depth placed, from _____ feet to _____ feet for each plug set.

Filled hole with heavy mud to 540'. Set plug. Put in 1/2 sack hulls and 20 sacks cement. Filled to 160'. Set plug. Put in 1/2 sack hulls and 20 sacks cement. Filled with heavy mud up to 40'. Set plug. Filled to top with 1/2 sack hulls and 10 sacks cement.

RECEIVED
STATE CORPORATION COMMISSION
AUG 13 1961
CONSERVATION DIVISION
Wichita, Kansas

(If additional description is necessary, use BACK of this sheet)

Name of Plugging Contractor C-G Drilling Co.
Address 107 Rule Building, Wichita 2, Kansas

STATE OF KANSAS, COUNTY OF SEDGWICK, ss.
G. F. Galloway (employee of owner) or (owner or operator) of the above-described well, being first duly sworn on oath, says: That I have knowledge of the facts, statements, and matters herein contained and the log of the above-described well as filed and that the same are true and correct. So help me God.
(Signature) G. F. Galloway
(Address) 107 Rule Building

SUBSCRIBED AND SWORN to before me this 16th day of August, 1961

My commission expires May 20, 1963

Vicky Jacobs
Notary Public.



W E L L L O G

OPERATOR C-G Drilling Co. & Benedict Oil Associates SEC. 22-11S-23W
 WELL NAME Hille #1 LOC. NE NE SE
 TOTAL DEPTH 3900' COUNTY Trego
 COMM. August 4, 1961 COMP. August 13, 1961 STATE Kansas
 RIG NO. 2 ELEVATION 2392' R.B.
 CASING: Ran 176.76' (6 jts.) 8-5/8" OD Surface Casing. PRODUCTION: D & A

All measurements taken from the top of rotary bushing.

FROM	TO	FORMATION	DEVIATION FROM VERTICAL	REMARKS:
0	175	Shale		
175	455	Shale & Shells		
455	770	Shale & Shell		
770	1290	Shale & Shells		
1290	1865	Red Bed		
1865	1905	Anhydrite		
1905	2170	Shale & Shells		
2170	2280	Shale & Shell		
2280	2380	Shale & Shells		
2380	2705	Shale & Lime	00 - 2500	
2705	3115	Lime & Shale	00 - 2750	
3115	3225	Shale & Lime	00 - 3000	
3225	3528	Lime & Shale	00 - 3250	
3528	3900	Lime	00 - 3500	
			00 - 3750	

RECEIVED
 STATE CORPORATION COMMISSION
 AUG 18 1961
 CONSERVATION DIVISION
 Wichita, Kansas

STATE OF KANSAS)
) SS.
 COUNTY OF SEDGWICK)

The undersigned hereby certifies that to the best of his knowledge and belief, the above facts are true and correct.

C-G DRILLING CO.

By G. F. Galloway
 G. F. Galloway

SUBSCRIBED AND SWORN TO, BEFORE ME, THIS 16th day of August, 1961.

My commission expires:
 May 20, 1963

Vicky Jacobs
 Vicky Jacobs - Notary Public

