


WELL PLUGGING RECORD

Give All Information Completely  
Make Required Affidavit  
Mail or Deliver Report to:  
Conservation Division  
State Corporation Commission  
800 Bitting Building  
Wichita, Kansas

NORTH

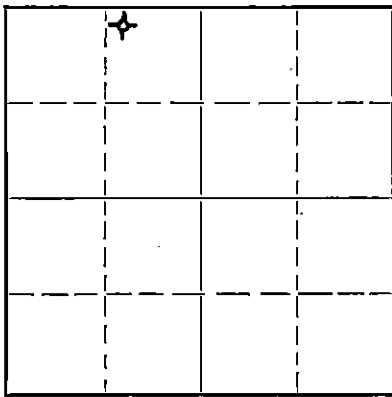

Locate well correctly on above  
Section Plat

Trego County, Sec 15 Twp 11S Rge 23 (W)  
Location as "NE/CNW $\frac{1}{4}$ SW $\frac{1}{4}$ " or footage from lines NW NE NW  
Lease Owner Imperial Drilling Company, Inc.  
Lease Name L. B. Walker Well No. 1  
Office Address 903 Union Natl Bank Bldg., Wichita, Kansas  
Character of Well (completed as Oil, Gas or Dry Hole) Dry Hole  
Date well completed December 30, 1953  
Application for plugging filed December 30, 1953  
Application for plugging approved December 30, 1953  
Plugging commenced December 30, 1953  
Plugging completed December 31, 1953  
Reason for abandonment of well or producing formation No oil in commercial quantities found  
If a producing well is abandoned, date of last production 19  
Was permission obtained from the Conservation Division or its agents before plugging was commenced? YES

Name of Conservation Agent who supervised plugging of this well Eldon Petty, Hays, Kansas  
Producing formation Depth to top Bottom Total Depth of Well 3718 Feet  
Show depth and thickness of all water, oil and gas formations.

OIL, GAS OR WATER RECORDS

CASING RECORD

Formation	Content	From	To	Size	Put In	Pulled Out
				8-5/8'	225'	

Describe in detail the manner in which the well was plugged, indicating where the mud fluid was placed and the method or methods used in introducing it into the hole. If cement or other plugs were used, state the character of same and depth placed, from feet to feet for each plug set.

Set #1 plug at 190' with 15 sacks cement. Filled hole with rotary mud to 40'. Set #2 plug with 10 sacks cement.

1-7-54

(If additional description is necessary, use BACK of this sheet)  
Name of Plugging Contractor Imperial Drilling Company, Inc.  
Address 903 Union National Bank Building  
Wichita 2, Kansas

STATE OF KANSAS, COUNTY OF SEDGWICK, ss.  
Raymond L. Bacon (employee of owner) or (owner or operator) of the above-described well, being first duly sworn on oath, says: That I have knowledge of the facts, statements, and matters herein contained and the log of the above-described well as filed and that the same are true and correct. So help me God.

(Signature) IMPERIAL DRILLING COMPANY, INC.  
By: Raymond L. Bacon Vice-Pres  
903 Union Natl Bank Bldg.  
Wichita 2, Kansas

SUBSCRIBED AND SWORN TO before me this 4th day of January, 1954.

Marilyn E. Fox  
Notary Public.

My commission expires November 9, 1957

PLUGGING  
FILE SEC 15 T 11 N  
BOOK PAGE 4 LINE 45  
6-51-20M

DRILLER'S LOG

Imperial Drilling Company, Inc.  
903 Union National Bank Building  
Wichita 2, Kansas

L. B. Walker #1  
NW NE NW Sec. 15-11S-23W  
Trego County, Kansas

Total Depth: 3718'

Elevation: 2247' R.B.

Commenced: 12-18-53 Completed: 12-30-53

2244' D.F.

Production: D & A

Contractor: Imperial Drilling Company, Inc.,  
Wichita, Kansas

Casing Record: Set 8-5/8" Surface Pipe at 225' with 200 sacks.

Figures indicate bottom of formations:

Surface Sand & Shells	165'		
Shale and Shells	225'		
Blue Shale	515'	<u>TOPS</u>	
Shale and Shells	685'		
Hard Sand & Pyrite	830'	Anhydrite	1704' ( /543' )
Shale and Shells	1260'	Heebner	3451' ( -1204' )
Dakota Sand	1465'	Toronto	3473' ( -1226' )
Red Bed and Shells	1490'	Lansing	3486' ( -1239' )
Shale and Shells	1704'	Rotary Total Depth	3718'
Anhydrite	1740"		
Shale and Shells	2245'		
Shale and Lime	2575'		
Hard Sand	2600'		
Shale and Lime	3436'		
Lime	3718'		
Total Depth	3718'		

We hereby certify this to be a correct and accurate log of the above described well as shown on the daily drilling reports.

IMPERIAL DRILLING COMPANY, INC.

By: Raymond L. Bacon Vice-Pres.  
Raymond L. Bacon

Subscribed and sworn to before me this 4th day of January, 1954.

Marilyn E. Joy  
Notary Public

My Commission Expires: November 9, 1957

