


WELL PLUGGING RECORD

Give All Information Completely
Make Required Affidavit
Mail or Deliver Report to:
Conservation Division
State Corporation Commission
211 No. Broadway
Wichita, Kansas

Trego County. Sec. 18 Twp. 11 Rge. 22 (E) (W)
Location as "NE/CNW%SW%" or footage from lines C of NE SE
Lease Owner Leo J. Dreiling Oil Company
Lease Name Lemke Well No. 1
Office Address Victoria, Kansas
Character of Well (completed as Oil, Gas or Dry Hole) Dry Hole
Date well completed 1-27-63 19__
Application for plugging filed 1-27-63 19__
Application for plugging approved 1-27-63 19__
Plugging commenced 1-27-63 19__
Plugging completed 1-27-63 19__
Reason for abandonment of well or producing formation -0-

NORTH

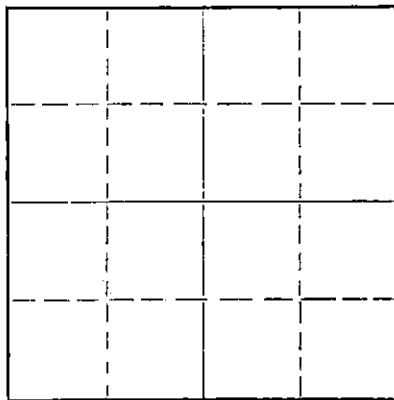

Locate well correctly on above
Section Plat

If a producing well is abandoned, date of last production -0- 19__
Was permission obtained from the Conservation Division or its agents before plugging was commenced? Yes

Name of Conservation Agent who supervised plugging of this well ~~XXXXXXXXXXXX~~ W. L. Nickles
Producing formation -0- Depth to top -0- Bottom -0- Total Depth of Well 3590' Feet
Show depth and thickness of all water, oil and gas formations.

OIL, GAS OR WATER RECORDS

CASING RECORD

FORMATION	CONTENT	FROM	TO	SIZE	PUT IN	PULLED OUT
Surface Pipe				8 5/8"	161'	-0-

Describe in detail the manner in which the well was plugged, indicating where the mud fluid was placed and the method or methods used in introducing it into the hole. If cement or other plugs were used, state the character of same and depth placed, from _____ feet to _____ feet for each plug set.

Rotary mud was used in filling hole to a depth of 540' were 1st plug was set using 20 sacks cement, 2nd plug was set at 150' using 20 sacks cement, and 3rd plug was set at 40' using 10 sacks cement and filling hole to surface.

STATE CORPORATION COMMISSION

FEB 25 1963

CONSERVATION DIVISION
Wichita, Kansas

(If additional description is necessary, use BACK of this sheet)

Name of Plugging Contractor L. J. Dreiling & Sons, Inc.
Address Victoria, Kansas

STATE OF Kansas, COUNTY OF Ellis, ss.
K. Leo F. Dreiling a partner (employee of owner) or (owner or operator) of the above-described well, being first duly sworn on oath, says: That I have knowledge of the facts, statements, and matters herein contained and the log of the above-described well as filed and that the same are true and correct. So help me God.

(Signature) Leo F. Dreiling
Leo F. Dreiling
(Address)

SUBSCRIBED AND SWORN to before me this 21st day of February, 19 63

My commission expires August 14, 1965

Robert Zimmerman
Notary Public.

L. J. DREILING and SONS, Inc.
VICTORIA, KANSAS

WELL LOG

Company Leo J. Dreiling Oil Company
Victoria, Kansas

Sec. 18 Twp. 11 Rng. 22

Farm Lemke No. 1

Location C of NE SE

Total Depth 3590'

County Trego

Comm. 1-21-63 Comp. 1-27-63

Elevation: D. F. 2219'

Contractor L. J. Dreiling & Sons, Inc.
Victoria, Kansas

G. R. 2217'

Casing Record

Cement Record

Production:

161' - - - - 8 5/8"

100 sacks cement

D. & A.

Figures Indicate Bottom of Formations

0 - 40
40 - 161
161 - 570
570 - 1185
1185 - 1400
1400 - 1574
1574 - 1691
1691 - 1729
1729 - 2030
2030 - 2334
2334 - 2605
2605 - 2704
2704 - 2880
2880 - 3060
3060 - 3227
3227 - 3340
3340 - 3436
3436 - 3504
3504 - 3590

Surface clay
Shale
Shale
Shale & Shells
Sand
Shale & Shells
Shale & Broken Lime
Anhydrite
Shale & Broken Lime
Lime & Shale
Lime & Shale
Lime
Lime & Shale
Lime
Shale & Lime Shells
Lime
Lime
Lime
Lime
TD

RECEIVED
STATE CORPORATION COMMISSION
FEB 25 1963
CONSERVATION DIVISION
Wichita, Kansas

STATE OF KANSAS)
) ss.
COUNTY OF ELLIS)

I, Leo F. Dreiling of the L. J. Dreiling & Sons, Inc., upon oath states that the above and foregoing is a true and correct copy of the log from the Daily Drilling Report on your Lemke No. 1.

Leo F. Dreiling
LEO F. DREILING

Subscribed and sworn to before me this 21st day of January, 1963.

Samuel Zimmerman
NOTARY PUBLIC

My Commission Expires: August 14, 1965