


STATE OF KANSAS  
STATE CORPORATION COMMISSION

15.195.00286.00.00

WELL PLUGGING RECORD

Give All Information Completely  
Make Required Affidavit  
Mail or Deliver Report to:  
Conservation Division  
State Corporation Commission  
800 Bittling Building  
Wichita, Kansas

TREGO County. Sec. 3 Twp. 11 Rge. (E) 21 (W)  
Location as "NE/CNW/SW" or footage from lines NW NE SW

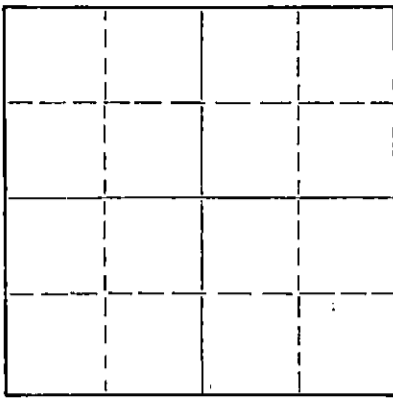

Locate well correctly on above Section Plat

Lease Owner THEODORE GORE  
Lease Name KROEGER Well No. A-1  
Office Address 650 FOURTH NATIONAL BANK BUILDING  
Character of Well (completed as Oil, Gas or Dry Hole) DRY HOLE  
Date well completed OCT. 11, 1957 19  
Application for plugging filed OCTOBER 11, 1957 19  
Application for plugging approved OCTOBER 11, 1957 19  
Plugging commenced OCTOBER 11, 1957 19  
Plugging completed OCTOBER 11, 1957 19  
Reason for abandonment of well or producing formation DRY HOLE

If a producing well is abandoned, date of last production 19  
Was permission obtained from the Conservation Division or its agents before plugging was commenced? YES

Name of Conservation Agent who supervised plugging of this well ELDON PETTY  
Producing formation Depth to top Bottom Total Depth of Well 3745 Feet  
Show depth and thickness of all water, oil and gas formations.

OIL, GAS OR WATER RECORDS

CASING RECORD

FORMATION	CONTENT	FROM	TO	SIZE	PUT IN	PULLED OUT
	SURFACE	0	206	8 5/8"	206	0

Describe in detail the manner in which the well was plugged, indicating where the mud fluid was placed and the method or methods used in introducing it into the hole. If cement or other plugs were used, state the character of same and depth placed, from feet to feet for each plug set.

BOTTOM PLUG AT 600', 20 SACKS CEMENT, MIDDLE PLUG AT 200', 20 SACKS CEMENT  
TOP PLUG AT 40', 10 SACKS CEMENT

(If additional description is necessary, use BACK of this sheet)

Name of Plugging Contractor  
Address

STATE OF KANSAS, COUNTY OF SEDGWICK, ss.  
I, DAN J. KORNFELD CONTRACTOR (employee of owner) or (owner or operator) of the above-described well, being first duly sworn on oath, says: That I have knowledge of the facts, statements, and matters herein contained and the log of the above-described well as filed and that the same are true and correct. So help me God.

(Signature) *Dan J. Kornfeld*  
650 FOURTH NATIONAL BANK BUILDING (Address)

SUBSCRIBED AND SWORN to before me this 17TH day of OCTOBER, 19 57

My commission expires JULY 2, 1958 *Hazel Pearson* Notary Public.

STATE CORP.

10-24-57

PLUGGING  
FILE SEC 3 T 11 R 21W  
BOOK PAGE 53 LINE 35

15.195.00286.00.00

L.O.G

COMPANY: THEODORE GORE WICHITA, KANSAS  
 CONTRACTOR: EMPIRE DRILLING COMPANY WICHITA, KANSAS  
 FARM: KROEGER NUMBER 9-1  
 LOCATION: NW NE SW SEC 3-11-21W TREGO COUNTY, KANSAS  
 COMMENCED: OCTOBER 1, 1957 ELEVATION: 2101 KB  
 COMPLETED: OCTOBER 11, 1957

0	TO	225	SURFACE
225	TO	1055	SHALE AND SHELLS
1055	TO	1560	SHALE AND SAND
1560	TO	1620	ANHYDRITE
1620	TO	2390	SHALE AND SHELLS
2390	TO	2485	SHALE AND LIME
2485	TO	2628	LIME AND SHALE
2628	TO	3012	SHALE AND LIME
3012	TO	3130	LIME AND SHALE
3130	TO	3270	SHALE AND LIME
3270	TO	3380	LIME AND SHALE
3380	TO	3440	SHALE AND LIME
3440	TO	3695	LIME
3695	TO	3745	SHALE AND LIME
		3745	RTD
			D. & A

SET: 8 5/8" AT 206' WITH 115 SACKS CEMENT

TOPS:	HEEBNER	3356
	TORONTO	3378
	LANSING KANSAS CITY	3395
	BASE KANSAS CITY	3631
	BASAL PENNSYLVANIAN CONGLOMERATE	3700

I, DAN J. KORNFIELD, DO HEREBY CERTIFY THAT THE ABOVE AND FOREGOING IS A TRUE AND CORRECT COPY OF THE LOG ON THE KROEGER NUMBER 2 NW NE SW SECTION 3-11-21, TREGO COUNTY, KANSAS AS REFLECTED BY THE FILES OF THE EMPIRE DRILLING COMPANY.

*Dan J. Kornfeld*  
DAN J. KORNFIELD

SUBSCRIBED AND SWORN TO BEFORE ME, A NOTARY PUBLIC WITHIN AND FOR SEDGWICK COUNTY, KANSAS THIS 17TH DAY OF OCTOBER 1957

MY COMMISSION EXPIRES JULY 2, 1958

*Hazel Pierson*  
HAZEL PIERSON, NOTARY PUBLIC

PLUGGING  
 FILE SEC 3 T 11 R 21W  
 BOOK PAGE 53 LINE 35

RECORDED  
 STATE CORPORATION COMMISSION  
 OCT 24 1957  
 CONSERVATION DIVISION  
 WICHITA, KANSAS