


WELL PLUGGING RECORD

Give All Information Completely
Make Required Affidavit
Mail or Deliver Report to:
Conservation Division
State Corporation Commission
212 North Market, Insurance Bldg.
Wichita, Kansas

Trego County, Sec. 15 Twp. 15S Rge. 24W (E) (W)

Location as "NE/CNWSW" or footage from lines 660' From S&E lines of NW/4
Lease Owner Sinclair Oil & Gas Company
Lease Name A. E. Montgomery Well No. 1
Office Address Box 466, Chase, Kansas
Character of Well (completed as Oil, Gas or Dry Hole) Dry Hole
Date well completed 11-4-60 19
Application for plugging filed 19
Application for plugging approved 11-4-60 (verbal Permission) 19
Plugging commenced 11-4-60 19
Plugging completed 11-4-60 19
Reason for abandonment of well or producing formation Dry Hole -
If a producing well is abandoned, date of last production 19
Was permission obtained from the Conservation Division or its agents before plugging was commenced? Yes

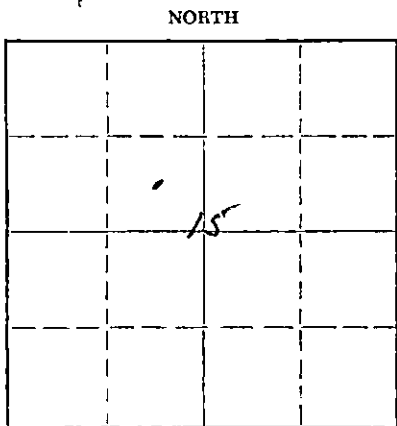

Locate well correctly on above Section Plat

Name of Conservation Agent who supervised plugging of this well Mr. Albert Leicker
Producing formation None Depth to top Bottom Total Depth of Well Feet
Show depth and thickness of all water, oil and gas formations.

OIL, GAS OR WATER RECORDS

CASING RECORD

FORMATION	CONTENT	FROM	TO	SIZE	PUT IN	PULLED OUT
None encountered				10-3/4"	761	None

Describe in detail the manner in which the well was plugged, indicating where the mud fluid was placed and the method or methods used in introducing it into the hole. If cement or other plugs were used, state the character of same and depth placed, from feet to feet for each plug set.

Filled from TD 4723 to 600' with heavy drilling mud, from 600' to 562' with 20 sacks cement, from 562' to 240' with drilling mud, from 240' to 202' with 20 sacks cement, from 202' to 35' with drilling mud and from 35' to surface with 20 sacks cement. Hole plugged as per Mr. Albert Leicker's instructions.

RECEIVED
STATE CORPORATION COMMISSION

NOV 14 1960

CONSERVATION DIVISION
Wichita, Kansas

(If additional description is necessary, use BACK of this sheet)
Name of Plugging Contractor Garvey Drilling Company
Address Route # 2, Great Bend, Kansas

STATE OF KANSAS, COUNTY OF RICE, ss. C. B. YORK (employee of owner) or (owner or operator) of the above-described well, being first duly sworn on oath, says: That I have knowledge of the facts, statements, and matters herein contained and the log of the above-described well as filed and that the same are true and correct. So help me God.

(Signature) C. B. York
P. O. Box 466, Chase, Kansas
(Address)

SUBSCRIBED AND SWORN TO before me this 10th day of November, 1960

My commission expires August 13, 1962
L. B. Reynolds Notary Public.

R

15.195.00379.00.00

DRILLER'S LOG

NAME OF OPERATOR: Sinclair Oil & Gas Company
 NAME OF CONTRACTOR: ~~XXXXXXXXXXXXXXXXXXXX~~, Garvey Drlg. Co., Great Bend, Kansas
 LEASE NAME: A. E. Montgomery # 1
 LOCATION: 660' from the Sout and East lines of NW/4 of section 15,
 15S-24W, Trego County, Kansas.

FROM	TO	FORMATION
0	75'	Surface clay and gravel
75	230	Shale and sand
230	650	Shale
650	764	Shale and lime stks.
764	830	Shale
830	1085	Sand
1085	1365	Shale and red bed
1365	1820	Shale and red bed
1820	1850	Anhydrite
1850	2374	Shale
2374	2696	Shale with lime stks.
2696	2967	Shale and lime
2967	3087	Shale
3087	3177	Shale, lime and chalk
3177	3343	Shale and lime
3343	3535	Lime and shale
3535	3665	Lime
3665	3820	Shale and lime
3820	4106	Lime and shale
4106	4157	Shale with lime stks.
4157	4355	Lime and shale
4355	4457	Cherty lime and dolomite
4457	4522	Cherty lime
4522	4643	Lime
4643	4679	Cherty lime
4679	4723	Lime - TD by driller

RECEIVED
 STATE CORPORATION COMMISSION
 NOV 14 1960
 CONSERVATION DIVISION
 Wichita, Kansas