

15.195.20201.00-00


STATE OF KANSAS  
STATE CORPORATION COMMISSION

Form CP-4

Give All Information Completely  
Make Required Affidavit  
Mail or Deliver Report to:  
Conservation Division  
State Corporation Commission  
212 No. Market  
Wichita, Kansas 67202

WELL PLUGGING RECORD

Trego \_\_\_\_\_ County, Sec. 21 Twp. 15S Rge. 23W (E) \_\_\_\_\_ (W)  
Location as "NE/CNW/SW" or footage from lines 1980' FN&EL  
Lease Owner The Cherokee & Pittsburg Coal and Mining Company  
Lease Name Harm Schneider Well No. 1  
Office Address 900 Polk Street, Amarillo, Texas 79101  
Character of Well (completed as Oil, Gas or Dry Hole) Dry Hole  
Date well completed January 3 19 72  
Application for plugging filed January 1, 19 72 \*  
Application for plugging approved January 1, 19 72 \*  
Plugging commenced January 2, 19 72  
Plugging completed January 2, 19 72  
Reason for abandonment of well or producing formation Dry Hole

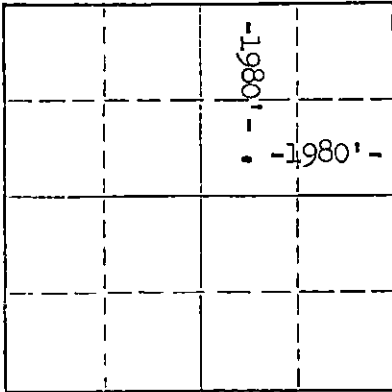

Locate well correctly on above  
Section Plat

If a producing well is abandoned, date of last production \_\_\_\_\_ 19 \_\_\_\_  
Was permission obtained from the Conservation Division or its agents before plugging was commenced? Yes

Name of Conservation Agent who supervised plugging of this well Bill Nichols  
Producing formation None Depth to top -- Bottom -- Total Depth of Well 2621 Feet  
Show depth and thickness of all water, oil and gas formations.

OIL, GAS OR WATER RECORDS

CASING RECORD

FORMATION	CONTENT	FROM	TO	SIZE	PUT IN	PULLED OUT
Lansing-Kansas City Group	Water	3784'	4076'	8-5/8"	375'	None
Ft. Scott	Water	4262'	4286'			
Cherokee Group	Water	4286'	4344'			
Mississippi	Water	4344'	4534'			
Viola	Water	4534'	4621' +			

Describe in detail the manner in which the well was plugged, indicating where the mud fluid was placed and the method or methods used in introducing it into the hole. If cement or other plugs were used, state the character of same and depth placed, from \_\_\_\_\_ feet to \_\_\_\_\_ feet for each plug set.

Spotted plugs as follows:  
900' to 583' w/70 sx 50-50 Pozmix  
309' to 400' w/20 sx 50-50 Pozmix  
Surface to 40' w/10 sx 50-50 Pozmix

RECEIVED  
STATE CORPORATION COMMISSION  
JAN 6 1972  
CONSERVATION DIVISION  
Wichita, Kansas

\*Plugged as per verbal approval of Bill Nichols, Kansas Corporation Commission.

(If additional description is necessary, use BACK of this sheet)

Name of Plugging Contractor Sterling Drilling Company  
Address \_\_\_\_\_

STATE OF Texas, COUNTY OF Potter, ss.

D. T. Stogner, Jr. (employee of owner) or (owner or operator) of the above-described well, being first duly sworn on oath, says: That I have knowledge of the facts, statements, and matters herein contained and the log of the above-described well as filed and that the same are true and correct. So help me God.

(Signature) D. T. Stogner Jr.  
900 Polk Street, Amarillo, Texas 79101  
(Address)

SUBSCRIBED AND SWORN TO before me this 4th day of January, 19 72

Barbara S. Cowgill Barbara S. Cowgill  
Notary Public.

My commission expires June 1, 1973