


STATE OF KANSAS  
STATE CORPORATION COMMISSION

Give All Information Completely  
Make Required Affidavit  
Mail or Deliver Report to:  
Conservation Division  
State Corporation Commission  
211 No. Broadway  
Wichita, Kansas

15.195.00144.00.00  
WELL PLUGGING RECORD

Trego County, Sec. 36 Twp. 15S Rge. 21W (E) (W)

NORTH

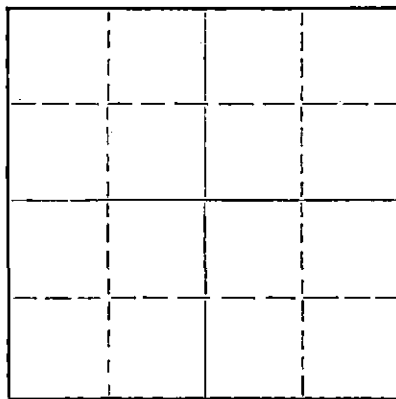

Locate well correctly on above Section Plat

Location as "NE/CNW%SW%" or footage from lines NW NW SW  
Lease Owner Don E. Pratt, et al  
Lease Name D. K. North Well No. B1  
Office Address Hays, Kansas  
Character of Well (completed as Oil, Gas or Dry Hole) Dry Hole  
Date well completed August 26 19 56  
Application for plugging filed August 27 19 56  
Application for plugging approved August 27 19 56  
Plugging commenced August 27 19 56  
Plugging completed August 27 19 56  
Reason for abandonment of well or producing formation Dry Hole

If a producing well is abandoned, date of last production \_\_\_\_\_ 19\_\_\_\_  
Was permission obtained from the Conservation Division or its agents before plugging was commenced? Yes

Name of Conservation Agent who supervised plugging of this well Norman Petty  
Producing formation \_\_\_\_\_ Depth to top \_\_\_\_\_ Bottom \_\_\_\_\_ Total Depth of Well 4395 Feet  
Show depth and thickness of all water, oil and gas formations.

OIL, GAS OR WATER RECORDS

CASING RECORD

FORMATION	CONTENT	FROM	TO	SIZE	PUT IN	PULLED OUT

Describe in detail the manner in which the well was plugged, indicating where the mud fluid was placed and the method or methods used in introducing it into the hole. If cement or other plugs were used, state the character of same and depth placed, from \_\_\_\_\_ feet to \_\_\_\_\_ feet for each plug set.

Filled hole w/ mud to 200'. Set Bottom plug, 1/2 sack hulls, cemented w/ 15 sax cement. Filled hole with mud to 40'. Set top plug, 1/2 sack hulls, cemented top plug w/ 10 sax cement.

(If additional description is necessary, use BACK of this sheet)

Name of Plugging Contractor Golden Cat Drilling Company  
Address WaKeeney, Kansas

STATE OF Kansas, COUNTY OF Trego, ss.  
W. E. Wickizer (employee of owner) or (owner or operator) of the above-described well, being first duly sworn on oath, says: That I have knowledge of the facts, statements, and matters herein contained and the log of the above-described well as filed and that the same are true and correct. So help me God.

(Signature) W. E. Wickizer  
WaKeeney, Kansas (Address)

SUBSCRIBED AND SWORN TO before me this 27th day of August, 19 56

My commission expires Sept. 10, 1959

Ray H. Horak  
Notary Public.

PLUGGING  
FILE SFC 36 T 15 R 21W  
BOOK PAGE 95 LINE 3

STATE CORPORATION COMMISSION  
Wichita, Kansas  
9-4-1956

# GOLDEN CAT DRILLING

and

15.195.00 | 44.00.00

# SERVICING COMPANY

Office Phone 379

P. O. Box 611

Residence Phone 350

To Don E. Pratt, et al.

Ways, Kansas

Well D.K. North E1 (NW NW SW) Sec. 36 Tw. 15S R. 21W Co. Trego

Total Depth: 4395'

Date Commenced: August 10, 1956

Completed: August 26, 1956

Dry Hole

0	to	209	Clay and shale
209		317	Shale
317		800	Shale and sand
800		1611	Shale, sand, pyrite
1611		1650	Anhydrite
1650		2200	Shale, shells, salt
2200		2305	Shale and lime
2305		2450	Cherty shale and lime
2450		2635	Lime and shale
2635		2685	Lime
2685		2975	Lime and shale
2975		3263	Shale and lime
3263		3488	Lime and shale
3488		3655	Lime and shale
3655		3775	Lime and shale
3775		3860	Lime
3860		3885	Lime and chert
3885		4065	Lime
4065		4156	Lime and chert
4156		4190	Shale, lime and sand
4190		4203	Lime
4203		4308	Shale and lime
4308		4395	Chert and lime

4395 TD

RECEIVED  
 CONSERVATION COMMISSION  
 SEP 8 1956  
 CONSERVATION DIVISION  
 WICHITA, KANSAS

*W. E. Wickizer*  
 W. E. Wickizer



**PLUGGING**  
 FILE SEC 36 T 15 R 21W  
 BOOK PAGE 95 LINE 3

*[Signature]*  
 Notary Public

STATE OF KANSAS

# INVOICE

August 31, 19 56

To: Don E. Pratt  
Box 656  
Hays, Kansas

STATE CORPORATION COMMISSION  
CONSERVATION DIVISION  
800 BITTING BUILDING  
WICHITA, KANSAS

FOR: PLUGGING ASSESSMENT AS FOLLOWS:

D. K. North # 1  
NW NW SW 36-15-21W  
Trego County  
File No. 95-3

\$ 25.00

NOTE: We also need a well plugging application, well log, and a well plugging record on this well to complete our file.

*Pd.*  
*ch # 1459*  
*c-7*  
*9-4-56*  
*E.W.*

**RETURN THIS COPY WITH REMITTANCE**

