


Give All Information Completely
Make Required Affidavit
Mail or Deliver Report to:
Conservation Division
State Corporation Commission
211 No. Broadway
Wichita, Kansas

WELL PLUGGING RECORD

Trego County, Sec. 35 Twp. 15S Rge. 21W (E) (W)

Location as "NE/CNWxSWx" or footage from lines C NE/4 NW/4
Lease Owner Walters Drilling Co.
Lease Name NORTH 'F' Well No. 1
Office Address 510 Orpheum Building, Wichita, Kansas
Character of Well (completed as Oil, Gas or Dry Hole) Dry Hole
Date well completed April 4th 19 63
Application for plugging filed April 4th 19 63
Application for plugging approved April 4th 19 63
Plugging commenced April 4th 19 63
Plugging completed April 4th 19 63
Reason for abandonment of well or producing formation _____

NORTH

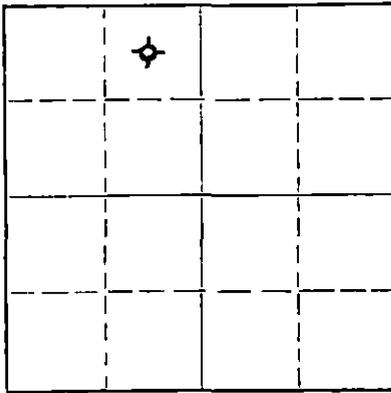

Locate well correctly on above
Section Plat

If a producing well is abandoned, date of last production _____ 19____
Was permission obtained from the Conservation Division or its agents before plugging was commenced? Yes, verbal approval

Name of Conservation Agent who supervised plugging of this well _____
Producing formation Mississippian Depth to top _____ Bottom _____ Total Depth of Well 4290 Feet
Show depth and thickness of all water, oil and gas formations.

OIL, GAS OR WATER RECORDS

CASING RECORD

| FORMATION | CONTENT | FROM | TO | SIZE | PUT IN | PULLED OUT |
|-----------|---------|------|----|--------|--------|------------|
| | | | | 8-5/8" | 165' | -0- |
| | | | | | | |
| | | | | | | |
| | | | | | | |
| | | | | | | |
| | | | | | | |
| | | | | | | |

Describe in detail the manner in which the well was plugged, indicating where the mud fluid was placed and the method or methods used in introducing it into the hole. If cement or other plugs were used, state the character of same and depth placed, from _____ feet to _____ feet for each plug set.

Set bottom plug at 540' ft. with 20 sacks cement.
Set second plug at 160' with 15 sacks cement.
Set top plug at 40' with 10 sacks cement.
Job complete @ 3:00 p.m.

RECEIVED
STATE CORPORATION COMMISSION

APR 10 1963

CONSERVATION DIVISION
Wichita, Kansas

(If additional description is necessary, use BACK of this sheet)

Name of Plugging Contractor Walters Drilling Co.
Address 510 Orpheum Building, Wichita, Kansas

STATE OF KANSAS, COUNTY OF SEDGWICK, ss.
ROBERT F. WALTERS (owner or operator) of the above-described well, being first duly sworn on oath, says: That I have knowledge of the facts, statements, and matters herein contained and the log of the above-described well as filed and that the same are true and correct. So help me God.
(Signature) Robert Walters
ROBERT F. WALTERS, Partner
510 Orpheum Building, Wichita, Kansas
(Address)

SUBSCRIBED AND SWORN to before me this 9th day of April, 19 63

My commission expires January 11th, 1967.

Velma L. Deines
Velma L. Deines
Notary Public.

NORTH 'F' #1

| | | |
|-----------------|--|--|
| LOCATION: | C NE/4 NW/4 Section 35-15S-21W Trego County, Kansas | SPUDDED: 3-25-63 |
| OPERATOR: | Walters Drilling Co. | COMPLETED: 4-4-63 |
| CONTRACTOR: | Walters Drilling Co. | ELEVATION: 2319 GL 2321 DF 2324 KB |
| SURFACE CASING: | 8-5/8" @ 165' with 90 sacks cement | |
| OIL STRING: | None | |

L O G
(Figures indicate bottom of formation)

| | |
|----------------|-------|
| Post Rock | 0-80' |
| Shale | 167' |
| Shale & Shells | 465' |
| Sand | 495' |
| Shale & Shells | 930' |
| Lime | 965' |
| Shale & Shells | 1064' |
| Sand | 1335' |
| Shale & Shells | 1638' |
| Anhydrite | 1687' |
| Shale & Shells | 2300' |
| Lime & Shale | 2360' |
| Lime | 2555' |
| Lime & Shale | 3490' |
| Lime | 3585' |
| Lime & Shale | 3905' |
| Lime | 3985' |
| Lime & Shale | 4115' |
| Lime & Chert | 4140' |
| Lime & Shale | 4174' |
| Shale & Sand | 4191' |
| Sand & Lime | 4241' |
| Lime & Shale | 4263' |
| Lime & Chert | 4290' |
| Total Depth | 4290' |

RECEIVED
STATE CORPORATION COMMISSION

APR 10 1963

CONSERVATION DIVISION
Wichita, Kansas

The undersigned, Robert F. Walters, hereby certifies that the above log is a true and correct log of the formations encountered in drilling the above noted well as reflected by the Daily Drilling Reports.

WALTERS DRILLING CO.

By

Robert F. Walters

ROBERT F. WALTERS, Partner

Subscribed and sworn to before me
this 9th day of April, 1963.

Velma L. Deines

Velma L. Deines, Notary Public

My commission expires January 11th, 1967.