


STATE OF KANSAS
STATE CORPORATION COMMISSION

WELL PLUGGING RECORD

Give All Information Completely
Make Required Affidavit
Mail or Deliver Report to
Conservation Division
State Corporation Comm.
245 North Water
Wichita, KS 67202

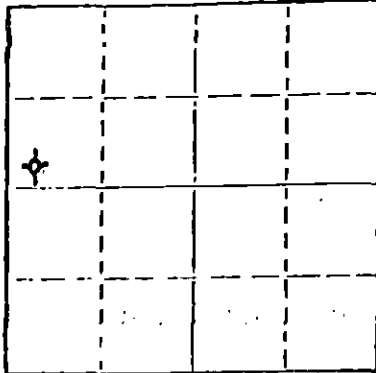

Locate well correctly on above
Section Plan

Trego County. Sec. 32 Twp. 15S Rge. 21 X/W
Location as "NE/CNW $\frac{1}{4}$ SW $\frac{1}{4}$ " or footage from lines
150' East of SW SW NW
Lease Owner Kedco Management Corporation
Lease Name Halbleib "B" Well No. 1
Office Address 816 Union Center Bldg., Wichita, KS 67202
Character of Well (Completed as Oil, Gas or Dry Hole)
Dry Hole
Date Well completed September 17 1976
Application for plugging filed September 17 1976
Application for plugging approved September 21 1976
Plugging commenced September 20 1976
Plugging completed October 25 1976
Reason for abandonment of well or producing formation
Non productive
If a producing well is abandoned, date of last production
19

Was permission obtained from the Conservation Division or
its agents before plugging was commenced? Yes

Name of Conservation Agent who supervised plugging of this well Gilbert Balthazor
Producing formation Depth to top Bottom Total Depth of Well 4340'
Show depth and thickness of all water, oil and gas formations.

OIL, GAS OR WATER RECORDS

CASING RECORD

FORMATION	CONTENT	FROM	TO	SIZE	PUT IN	PULLED OUT
				8 5/8"	248'	None
				4 1/2"	3905'	2219'

Describe in detail the manner in which the well was plugged, indicating where the mud fluid
was placed and the method or methods used in introducing it into the hold. If cement or other
plugs were used, state the character of same and depth placed, from feet to
feet for each plug set. Set cement plug (3sx.) above perforation from 3793 1/2'
to 3813'. Pumped 3 sx. of hulls and 70 sx. of 50/50 pozmix cement (6% gel) and 3 sx. gel down
surface casing. Released plug. Pumped 60 sx. of 50/50 pozmix cement into surface casing.
Maximum pressure of 500# and closing pressure of 250#. Plugging cementing by Allied Cementing
Co., Inc.

Obtained verbal permission to plug well from Corporation Commission on September 17, 1976.

STATE CORPORATION COMMISSION

11-12-1976
NOV 12 1976

(If additional description is necessary, use BACK of this sheet.)

Name of Plugging Contractor Brown Bros. Well Service, Inc., Plainville, KS

STATE OF KANSAS COUNTY OF SEDGWICK ss.

Wayne L. Brinegar, Vice President (employee of owner) or (owner or operator) of the above-described
well, being first duly sworn on oath, says: That I have knowledge of the facts, statements, and matters herein contained and the log of the
above-described well as filed and that the same are true and correct. So help me God.

(Signature)

Wayne L. Brinegar

816 Union Center Bldg., Wichita, KS 67202

(Address)

Subscribed and Sworn to before me this 10th day of November 1976

My commission expires October 29, 1978

Kay Woolsey

Notary Public.

15.195.20377.00.00

KEDCO

CONTRACTOR'S WELL LOG

WELL FILE

OPERATOR: KEDCO Management Corporation
CONTRACTOR: Abercrombie Drilling, Inc.
WELL NAME: HALBLEIB "B" #1
LOCATION: SW SW NW, Section 32-15S-21W
Trego County, Kansas
SPUD DATE: August 20, 1976
COMPLETION DATE: September 5, 1976

0	249	Surface Clay & Shale
249	790	Sand and Shale & Red Beds
790	1173	Sand & Shale
1173	1377	Sand
1377	1709	Sand & Shale
1709	1747	Anhydrite
1747	2380	Shale
2380	2550	Shale & Lime
2550	2703	Shale
2703	3100	Shale & Lime
3100	3230	Lime & Shale
3230	3480	Shale & Lime
3480	3910	Lime & Shale
3910	3955	Shale & Lime
3955	4274	Lime & Shale
4274	4280	Lime & Shale & Chert
4280	4291	Lime & Shale
4291	4340	Lime & Chert
	4340	Rotary Total Depth

Spudded at 12:00 a.m., 8-20-76. Drilled 249' of 12 $\frac{1}{4}$ " hole, ran 6 jts. used 8 5/8" casing, set at 248' with 160 sx. common, 2% gel, 3% Ca, Cl. Plug was down at 6:00 p.m., 8-20-76. Cement circulated, start under surface at 7:30 a.m. 8-21-76.

T.D. 4340', (Pipe tally 3902' overall). Set 117 jts, new 10 $\frac{1}{2}$ " - 4 $\frac{1}{2}$ " casing at 3905'. Cemented with 150 sx. salt saturated cement, Job complete at 1:45 a.m. 9-05-76.

SAMPLE TOPS:

Anhydrite 1709' (+681)
B/Anhydrite 1747' (+643)

RECEIVED
STATE COMMISSION

COPY

SEP 21 1976

STATE OF KANSAS)
COUNTY OF SEDGWICK) SS

CONSERVATION DIVISION
Wichita, Kansas

Jerry A. Langrehr, Executive Vice President of Abercrombie Drilling, Inc., does hereby state that the above and foregoing is a true and correct copy of the log of the HALBLEIB "B" #1, SW SW NW, Section 32-15S-21W, Trego County, Kansas.

ABERCROMBIE DRILLING, INC.

By: Jerry A. Langrehr
Jerry A. Langrehr, Exec. V.P.

Subscribed and sworn to before me, a Notary Public, in and for the aforesaid county and state as of this 7th day of September, 1976.

My Commission Expires: July 21, 1979.

Sandra Richman
Sandra Richman, Notary Public