

STATE OF KANSAS
STATE CORPORATION COMMISSION


Form CP-4

Give All Information Completely
Make Required Affidavit
Mail or Deliver Report to:
Conservation Division
State Corporation Commission
212 No. Market
Wichita, Kansas

WELL PLUGGING RECORD

Trego County, Sec. 15 Twp. 15S Rge. 21W (E) (W)
Location as "NE/CNW%SW%" or footage from lines Center SE NW
Lease Owner D & D Drilling Company, Inc.
Lease Name Price Well No. 1
Office Address 307 Schweiter Bldg. Wichita, Kansas
Character of Well (completed as Oil, Gas or Dry Hole) Dry Hole
Date well completed 12-12-65 19
Application for plugging filed 12-15-65 19
Application for plugging approved 12-12-65 19
Plugging commenced 12-12-65 19
Plugging completed 12-12-65 19
Reason for abandonment of well or producing formation Dry hole

NORTH

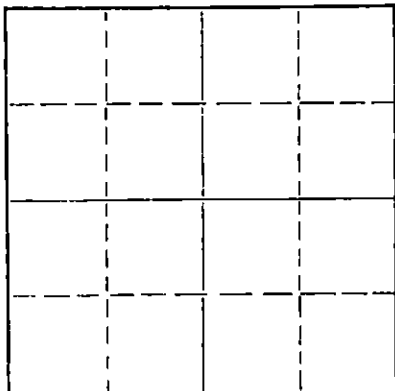

Locate well correctly on above Section Plat

If a producing well is abandoned, date of last production 19
Was permission obtained from the Conservation Division or its agents before plugging was commenced? Yes

Name of Conservation Agent who supervised plugging of this well Gilbert Leiker, Victoria, Kansas
Producing formation Depth to top Bottom Total Depth of Well 4160 Feet
Show depth and thickness of all water, oil and gas formations.

OIL, GAS OR WATER RECORDS

CASING RECORD

FORMATION	CONTENT	FROM	TO	SIZE	PUT IN	PULLED OUT
Surface hole		0	231'	8 5/8"	12-3-65	

Describe in detail the manner in which the well was plugged, indicating where the mud fluid was placed and the method or methods used in introducing it into the hole. If cement or other plugs were used, state the character of same and depth placed, from feet to feet for each plug set.

Set Plug #1 at 540' with 20 sacks cement

Set Plug #2 at 220' with 20 sacks cement

Set Plug #3 at 40' with 10 sacks cement.

DEC 17 1965
12-17-1965

(If additional description is necessary, use BACK of this sheet)

Name of Plugging Contractor D & D Drilling Company, Inc.
Address 307 Schweiter Building, Wichita, Kansas

STATE OF Kansas, COUNTY OF Sedgwick, ss.
James R. Daniels (employee of owner) or (owner or operator) of the above-described well, being first duly sworn on oath, says: That I have knowledge of the facts, statements, and matters herein contained and the log of the above-described well as filed and that the same are true and correct. So help me God.

(Signature) James R. Daniels
James R. Daniels
307 Schweiter Bldg. Wichita, Kansas
(Address)

SUBSCRIBED AND SWORN TO before me this 15th day of December, 1965

My commission expires 11-18-66 Colleen Chapple Notary Public

ROTARY DRILLING LOG

OPERATOR:	D & D Drilling Company, Inc.	COMMENCED:	12-3-65
CONTRACTOR:	D & D Drilling Company, Inc.	COMPLETED:	12-12-65
WELL:	Price No. 1	ELEVATION:	2173 K.B.
LOCATION:	Center SE NW		2170 D.F.
	Section 15-T15S-R21W		2168 G.L.
COUNTY:	Trego, Kansas	TOTAL DEPTH:	4160'

DEC 17 1965

Formations	Depth	Remarks
Rock & Sand	231'	Set 5 joints of 8 5/8" casing with 200 sacks of cement.
Shale & Sand	1518'	
Ahhydrite	1569'	
Shale & Sand	1895'	
Shale	2265'	
Shale & Lime	2573'	
Shale	2666'	
Shale & Lime	3255'	
Shale	3375'	
Shale & Lime	3620'	
Lime	4160'	
Rotary Total Depth	4160'	D & A

A F F I D A V I T

State of Kansas)
) SS
 County of Sedgwick)

I, James R. Daniels, of lawful age, being duly and solimnly sworn on oath says: I am a resident of Wichita, Sedgwick County, Kansas, and I hereby know and on oath state that the above drilling log is true and correct to the best of my knowledge and belief.

James R Daniels

 James R. Daniels

Subscribed and sworn to before me this 15th day of December, 1965.

My Commission Expires 11-18-66

Colleen Chapple

 Colleen Chapple - Notary Public

