


STATE OF KANSAS
STATE CORPORATION COMMISSION

WELL PLUGGING RECORD

Give All Information Completely
Make Required Affidavit
Mail or Deliver Report to:
Conservation Division
State Corporation Commission
211 No. Broadway
Wichita, Kansas

Trego County. Sec. 15 Twp. 15 Rge. 21 (S) W (W)
Location as "NE/CNW/SW" or footage from lines NE NE NW
Lease Owner E. K. Carey Drilling Co., Inc.
Lease Name Harley Price Well No. 1
Office Address Box 620, McPherson, Kansas
Character of Well (completed as Oil, Gas or Dry Hole) Dry hole
Date well completed June 25, 19 57
Application for plugging filed June 24, 19 57
Application for plugging approved June 24, 19 57
Plugging commenced 9:30 P.M. June 25, 19 57
Plugging completed 11:30 P.M. June 25, 19 57
Reason for abandonment of well or producing formation Dry hole

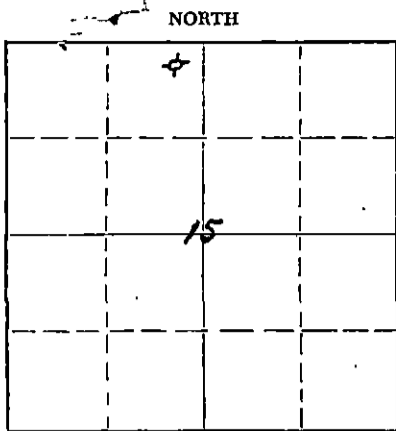

Locate well correctly on above
Section Plat

If a producing well is abandoned, date of last production 19
Was permission obtained from the Conservation Division or its agents before plugging was commenced? Yes

Name of Conservation Agent who supervised plugging of this well Eldon Petty, Hays, Kansas
Producing formation Depth to top Bottom Total Depth of Well 4134 Feet
Show depth and thickness of all water, oil and gas formations.

OIL, GAS OR WATER RECORDS

CASING RECORD

FORMATION	CONTENT	FROM	TO	SIZE	PUT IN	PULLED OUT
				8-5/8	306	None

Describe in detail the manner in which the well was plugged, indicating where the mud fluid was placed and the method or methods used in introducing it into the hole. If cement or other plugs were used, state the character of same and depth placed, from 600-525 feet to 40-8 feet for each plug set.

Gunned pits, circulated heavy mud around, layed down all but 20 jts. of drill pipe, pushed plug to 600 feet. Madebridge with tree limb and rock to hold weight of 20 joints drill pipe, cemented by Halliburton thru drill pipe with 25 sacks. Filled with heavy mud to 40', set plug and 1/2 sack hulls and mixed 10 sacks cement and filled to bottom of cellar floor. Through at 11:30 P.M.

(If additional description is necessary, use BACK of this sheet)

Name of Plugging Contractor E. K. Carey Contractor
Address Box 620, McPherson, Kansas

STATE OF Kansas, COUNTY OF McPherson, ss.
Arland Bruce (employee of owner) or (owner or operator) of the above-described well, being first duly sworn on oath, says: That I have knowledge of the facts, statements, and matters herein contained and the log of the above-described well as filed and that the same are true and correct. So help me God.

(Signature) Arland Bruce
Box 620, McPherson, Kansas
(Address)

SUBSCRIBED AND SWORN TO before me this 26th day of June, 19 57

My commission expires November 13, 1960

Notary Public.

6-28-1957
CONSERVATION DIVISION
Wichita, K. FILED
PLUGGING
SEC 15 T 15 R 21W
BOOK PAGE 23 LINE 44

ROTARY DRILLER'S LOG

E. K. Carey Drilling Co., Inc.
Box 620
McPherson, Kansas

Elevations: 2175 K.B.
2173 D.F.
2170 Gr.

Price #1

Casing Record:

C, NE NE NW
Sec. 15-15-21W
Trego County, Kansas

8-5/8" @ 306' w/250 sks.
Pozmix cement and 500# cc.

Well Commenced: 5-26-57 to 5-28-57
Well Commenced: 6-10-57
Well Completed: 6-26-57 D & A

Contractor: E. K. Carey Contractor, Rig #1, Box 620, McPherson, Kansas
Geologist: Ed. Sabatka, E. K. Carey Drlg. Co. 815 Central Bldg. Wichita

Figures Indicate Bottom of Formation K. B.

cellar	8
shale and shells	200
shale	535
sand	590
shale	800
sand	830
shale	850
sand	1015
redbed	1320
shale and redbed	1520
anhydrite	1560
shale and redbed	1750
shale	1850
shale and lime	2120
lime and shale	2442
lime	2820
lime and shale	3426
lime	3825
shale and lime	3933
lime and chert	3990
lime, shale and sand	4025
lime and sand	4045
lime, shale and sand	4085
shale	4094
Miss. Chert	4134 TD

Geologist Tops:

Heebner	3553 (-1378)
Toronto	3576 (-1401)
Lansing	3595 (-1420)
Base K.C.	3851 (-1676)
Marmaton	3931 (-1756)
Cherokee	3999 (-1824)
Mississippian	4094 (-1919)

Rotary Total Depth 4134

#1 DST - 3995 to 4020 or 25' anchor. Tool open 1 hr. weak blow. Closed 30 min. for BHP. Recovered 65' oil specked mud. BHP 527#.

#2 DST - 4023 to 4045 or 22' anchor. Tool open 30 min. weak blow died in 3 min. Closed 20 min. for BHP. Recovered 8' drilling mud. BHP 198#, no oil show.

#3 DST - 4053 to 4080 or 27' anchor. Tool open 1 hr. with strong blow, decreased to weak blow. Closed 30 min. for BHP. Recovered 1440' salt water. BHP 1093# IFP 210# and FFP 682#.

This is to certify that the above information is to the best of my knowledge true and correct.

SUBSCRIBED and Sworn to before me this 27th day of June, 1957.

RECEIVED
STATE COMMISSION

JUN 28 1957

CONSERVATION DIVISION
Wichita, Kansas

E. K. CAREY CONTRACTOR

BY Herbert Rhoton
Herbert Rhoton, Superintendent

My Commission Expires: November 13, 1960

PLUGGING	
FILE SEC	15 T. 15 R. 21W
BOOK PAGE	23 LINE 44

NP