

STATE OF KANSAS
STATE CORPORATION COMMISSION

WELL PLUGGING RECORD

Give All Information Completely
Make Required Affidavit
Mail or Deliver Report to:
Conservation Division
State Corporation Commission
212 No. Market
Wichita, Kansas

Trego County, Sec. 13 Twp. 15S Rge. 21 (E) (W)

Location as "NE/CNW/SW" or footage from lines 150 NE of C NE SE

Lease Owner Rains & Williamson Oil Co., Inc.

Lease Name BRENNER "A" Well No. 1

Office Address 1425 Wichita Plaza - Wichita, Kansas

Character of Well (completed as Oil, Gas or Dry Hole) Dry Hole

Date well completed 7-4 1967

Application for plugging filed 7-4 1967

Application for plugging approved 7-4 1967

Plugging commenced 7-4 1967


Plugging completed 7-4 1967

Reason for abandonment of well or producing formation No oil or gas

found in commercial quantities.

If a producing well is abandoned, date of last production -- 19--

Was permission obtained from the Conservation Division or its agents before plugging was commenced? Yes

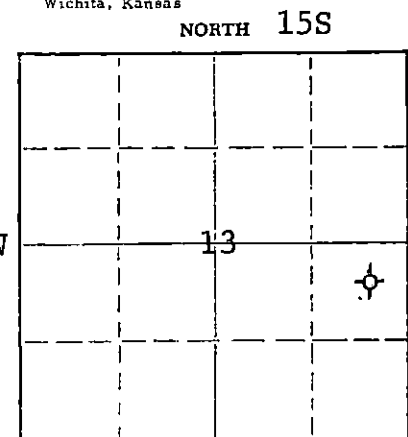

Locate well correctly on above Section Plat

Name of Conservation Agent who supervised plugging of this well Bill Nichols, Moreland, Kansas

Producing formation None Depth to top Bottom Total Depth of Well 4059 Feet

Show depth and thickness of all water, oil and gas formations.

OIL, GAS OR WATER RECORDS

CASING RECORD

FORMATION	CONTENT	FROM	TO	SIZE	PUT IN	PULLED OUT
				8-5/8"	207.10'	-0-

Describe in detail the manner in which the well was plugged, indicating where the mud fluid was placed and the method or methods used in introducing it into the hole. If cement or other plugs were used, state the character of same and depth placed, from feet to feet for each plug set.

Pushed plug to 720' and spot with 20 sacks cement. Mud back to 210'. Cement through drill pipe with 20 sacks cement. Mud back to 40', set solid bridge and capped with 10 sacks, 2 sacks in rat hole. Plugging completed at 11:30 A.M., July 4, 1967.

RECEIVED
STATE CORPORATION COMMISSION
JUL 7 1967
CONSERVATION DIVISION
WICHITA, KANSAS
7-1967

Name of Plugging Contractor Rains & Williamson Oil Co., Inc.
Address 1425 Wichita Plaza - Wichita, Kansas

STATE OF KANSAS, COUNTY OF SEDGWICK, ss. Wilson Rains

(owner or operator) of the above-described well, being first duly sworn on oath, says: That I have knowledge of the facts, statements, and matters herein contained and the log of the above-described well as filed and that the same are true and correct. So help me God.

(Signature) Wilson Rains
1425 Wichita Plaza - Wichita, Kansas
(Address)

SUBSCRIBED AND SWORN to before me this 6 day of July, 1967

My commission expires 3-3-70

Mary J. Brown
Notary Public.

ROTARY DRILLING LOG

Operator: Rains & Williamson
Oil Co., Inc.
BRENNER "A" #1
150' NE of C NE SE
Section 13-15S-21W
Trego County, Kansas

Contractor: Rains & Williamson
Oil Co., Inc. (Rig 2)
Commenced: 6-24-67
Completed: 7-4-67
Remarks: Set 8-5/8" surface
casing at 207.10'
w/165 sacks GL-3.

Formations:

Post Rock	20'
Sand and Shale	210'
Shale	950'
Sand	1230'
Red Bed & Shale	1503'
Anhydrite	1578'
Shale	2148'
Lime and Shale	3595'
Lime	3885'
Lime and Chert	3943'
Lime	4059'
Rotary Total Depth (D & A)	4059'

RECEIVED
STATE CORPORATION COMMISSION

JUL 7 1967


CONSERVATION DIVISION
Wichita, Kansas

We certify the above log is
true and correct to the best of
our knowledge and belief.

RAINS & WILLIAMSON OIL CO., INC.


Wilson Rains

Subscribed and sworn to before me, a Notary Public in and for the State of
Kansas, County of Sedgwick, this 6th day of July, 1967.

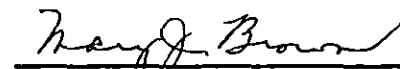
Mary J. Brown Notary Public

My Commission Expires:
March 3, 1970