


WELL PLUGGING RECORD

Give All Information Completely
Make Required Affidavit
Mail or Deliver Report to:
Conservation Division
State Corporation Commission
211 No. Broadway
Wichita, Kansas

NORTH

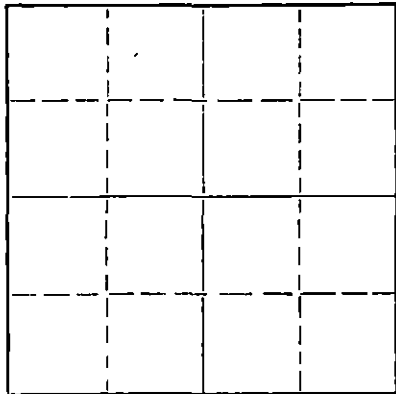

Locate well correctly on above
Section Plat

Trego County. Sec. 6 Twp. 15S Rge. 21W (E) (W)
Location as "NE/CNW/SW" or footage from lines C SE NE
Lease Owner Omega Drilling, Inc. et al
Lease Name Alois Engel Well No. #1
Office Address 427 Union Center, Wichita, Kansas
Character of Well (completed as Oil, Gas or Dry Hole) Dry Hole
Date well completed May 3 1965
Application for plugging filed May 3 1965
Application for plugging approved May 3 1965
Plugging commenced May 3 1965
Plugging completed May 3 1965
Reason for abandonment of well or producing formation Dry Hole

If a producing well is abandoned, date of last production 19____
Was permission obtained from the Conservation Division or its agents before plugging was commenced? Yes

Name of Conservation Agent who supervised plugging of this well W. L. Nichols, Moreland, Kansas
Producing formation _____ Depth to top _____ Bottom _____ Total Depth of Well 4218 Feet
Show depth and thickness of all water, oil and gas formations.

OIL, GAS OR WATER RECORDS

CASING RECORD

FORMATION	CONTENT	FROM	TO	SIZE	PUT IN	PULLED OUT

Describe in detail the manner in which the well was plugged, indicating where the mud fluid was placed and the method or methods used in introducing it into the hole. If cement or other plugs were used, state the character of same and depth placed, from _____ feet to _____ feet for each plug set.

Plug w/ 20 sx cement @ 600'; 20 sx cement @ 240'; filled 40' to 4' under ground level - 2 sx hulls and plug @ 40'. Jet pits and cellar.

RECEIVED
STATE CORPORATION COMMISSION
MAY 12 1965
5-12-1965
CONSERVATION DIVISION
Wichita, Kansas

(If additional description is necessary, use BACK of this sheet)

Name of Plugging Contractor _____
Address _____

STATE OF Kansas, COUNTY OF Sedgwick, ss.
F. S. Woodside, Jr. (employee of owner) or (owner or operator) of the above-described well, being first duly sworn on oath, says: That I have knowledge of the facts, statements, and matters herein contained and the log of the above-described well as filed and that the same are true and correct. So help me God.

(Signature) F. S. Woodside, Jr.
427 Union Center, Wichita, Kansas
(Address)

SUBSCRIBED AND SWORN TO before me this 10th day of May 1965

My commission expires January 8, 1968

Lois J. McBooy
Lois J. McBooy Notary Public.

ROTARY DRILLING LOG

Operator: Omega Drilling, Inc.
 #1 Alois Engel
 C SE NE Section 6-15S-21W
 Trego County, Kansas

Contractor: Omega Drilling, Inc.
 Commenced: April 23, 1965
 Completed: May 3, 1965

Remarks: Set 8 5/8" surface casing @ 615' w/320 sx Posmix 2% CC

Formations:

0 - 615	Shale, Sand, Lime and Shells
615 - 1085	Shale, Sand, and Shells
1085 - 1179	Sand
1179 - 1272	Sand and Shale
1272 - 1584	Shale and Shells
1584 - 1606	Anhydrite
1606 - 1990	Shale and Lime
1990 - 2232	Shale and Lime
2232 - 2274	Shale and Lime
2274 - 2455	Shale and Lime
2455 - 2655	Shale and Lime
2655 - 2824	Lime and Shale
2824 - 3278	Shale and Lime
3278 - 3693	Lime and Shale
3693 - 3877	Lime
3877 - 3965	Lime
3965 - 3995	Lime
3995 - 4060	Chert and Lime
4060 - 4115	Shale, Sand and Lime
4115 - 4180	Shale, Lime and Sand
4180 - 4200	Shale and Sand
4200 - 4215	Mississippi Chert and Lime
4215 -	T.D.

We certify the above log is true and correct to the best of our knowledge and belief.

OMEGA DRILLING, INC.

F. S. Woodside, Jr.

F. S. Woodside, Jr.
 Executive Vice-President

Subscribed and sworn to before me, a Notary Public, in and for the State of Kansas, County of Sedgwick, this 5th day of May, 1965.

My Commission Expires January 8, 1968

Lois J. McCoy
 Lois J. McCoy, Notary Public