

STATE OF KANSAS
STATE CORPORATION COMMISSION

WELL PLUGGING RECORD


Give All Information Completely
Make Required Affidavit
Mail or Deliver Report to:
Conservation Division
State Corporation Commission
800 Bitting Building
Wichita, Kansas

OR

Strike out upper line
when reporting plug-
ging off formations.

~~WELL PLUGGING RECORD~~

NORTH

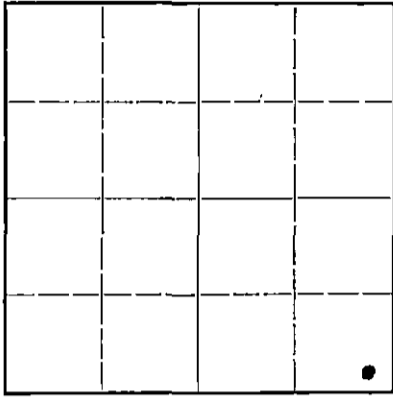

Locate well correctly on above
Section Plat

Trego County, Sec. 26 Twp. 14 Rge. (E) 25 (W)
Location as "NE 1/4 NW 1/4 SW 1/4" or footage from lines SE/4 330' fm Sth & East lines

Lease Owner. Sinclair Prairie Oil Co

Lease Name. Thomas O'Toole Well No. 1

Office Address. Bx 521, Tulsa. Okla

Character of Well (completed as Oil, Gas or Dry Hole) dry hole

Date well completed. Nov. 10 1944

Application for plugging filed. Nov. 15 1944

Application for plugging approved. Nov. 17 1944

Plugging commenced. Nov. 14 1944

Plugging completed. Nov. 14 1944

Reason for abandonment of well or producing formation. dry hole completion

If a producing well is abandoned, date of last production. - 19

Was permission obtained from the Conservation Division or its agents before plugging was commenced? Yes

Name of Conservation Agent who supervised plugging of this well. H.W. Kerr

Producing formation. none Depth to top. Bottom. Total Depth of Well. 4505 Feet

Show depth and thickness of all water, oil and gas formations.

OIL, GAS OR WATER RECORDS

CASING RECORD


Formation	Content	top From	To	Size	Put In	Pulled Out
Topeka	dry	3275'		10"	200	0
Lan-Kc	"	3620	3815			
Miss	"	4110				
Viola	"	4325				
Arbuckle	"	4415				
				No Material Recovered		

Describe in detail the manner in which the well was plugged, indicating where the mud fluid was placed and the method or methods used in introducing it into the hold. If cement or other plugs were used, state the character of same and depth placed, from feet to feet for each plug set.

- 4505 - 206' mud
- 206 - 172' plug & 15' sx cmt
- 172 - 32' mud
- 32 - to top surface csg - 15' sx cmt

11-30-1944

PLUGGING
FILE NO. 26 14 25 W
NOV 14 1944

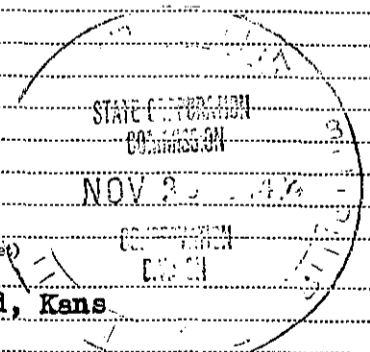

(If additional description is necessary, use BACK of this sheet)

Correspondence regarding this well should be addressed to Victor Chancellor
Address. Bx 774 Great Bend, Kans

STATE OF Kansas, COUNTY OF Barton, ss.

I, Victor Chancellor (employee of owner) or (owner) of the above-described well, being first duly sworn on oath, says: That I have knowledge of the facts, statements, and matters herein contained and the log of the above-described well as filed and that the same are true and correct. So help me God.

(Signature) Victor Chancellor
Bx 774 Great Bend, Kans (Address)

SUBSCRIBED AND SWORN to before me this 28th day of November, 1944

My commission expires 6-14-47
Notary Public.

Sinclair Prairie Oil Co
Well Log

15.195.00412.00.00

Thomas O Toole # 1
SE/4, 26-14-25W, Trego Co., Kans.
330 ft fm Sth & East lines
Elev. 2239'

Harbar Drilling Co.-rotary
Began drlg Oct. 13, 1944
Comp. drlg Nov. 10, 1944
T.D. 4505' DRY HOLE

Drillers Log

Surface Clay & Sand	17'
Sand	35
Bentonite & Shale	55
Shale & Shells	230
Shale & Shells	300
Sand	315
Shale & Shells	600
Sand	690
Shale & Shells	900
Red Bed & Shells	1196
Red Bed & Sand	1440
Red Bed	1690
Anhydrite	1732
Shale & Shells	1960
Red Bed & Shale	2115
Salt & Shells	2160
Shale	2195
Shale & Lime	2375
Shale & Shells	2500
Shale	2565
Shale & Lime	2610
Shale	2640
Shale & Lime	2805
Shale & Shells	2880
Shale & Lime	3070
Lime	3170
Shale & Lime	3245
Lime	3660
Shale & Lime	3890
Shale	3930
Shale & Lime	3990
Shale	4045
Shale & Lime	4110
Lime	4135
Shale & Lime	4153
Cherty Lime	4173
Chert	4174 1/2
Cherty Lime	4181
Lime-hard	4189
Chert-Lime	4216
Lime-hard	4228
Cherty-Lime	4245
Lime-hard	4260
Sand	4265
Lime	4400
Lime & Chert steaks	4505 TD

10" set at 206' w/ 200 sx.

Top Topeka 3275'

Top Kan-Kc 3620-3815'

Top Miss. 4110

Top Viola 4325

Top Arbuckle 4415'

Ran Schlumberger survey, no shows of oil
or gas anywhere. Dry hole

Plugged & abandoned 11/14/1944.

PLUGGED
26 14 25W
140 13
NOV 13 1944