

COPY

STATE CORPORATION COMMISSION OF KANSAS  
OIL & GAS CONSERVATION DIVISION  
WELL COMPLETION OR RECOMPLETION FORM  
ACO-1 WELL HISTORY  
DESCRIPTION OF WELL AND LEASE

API NO. 15-195-20,027-A  
County Trego  
150' NE of  
C... NE... SE... Sec. 13... Twp. 15S... Rge. 21... X West

Operator: License # 5135  
Name John O. Farmer, Inc.  
Address P.O. Box 352  
Russell, KS 67665  
City/State/Zip

2020 Ft North from Southeast Corner of Section  
600 Ft West from Southeast Corner of Section  
(Note: Locate well in section plat below)

Purchaser none - dry hole

Lease Name Brenner "C" Well #1 "OWNO"

Field Name Meserve

Operator Contact Person Margaret Schulte  
Phone (913) 483-3144

Producing Formation Cherokee Sand


Elevation: Ground 2253' KB 2258'

Contractor: License # 5135  
Name John O. Farmer, Inc.

Wellsite Geologist Sam Farmer  
Phone (913) 483-3144

Designate Type of Completion  
New Well Re-Entry X Workover  
Oil SWD Temp Abd  
Gas Inj Delayed Comp.  
X Dry Other (Core, Water Supply etc.)

Section Plat

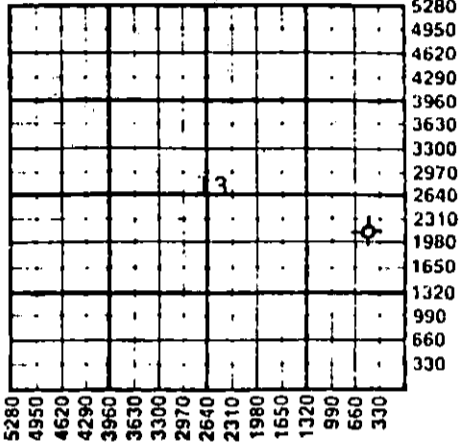

If O.W.N.O.: old well info as follows:  
Operator Rains & Williamson Oil Co.  
Well Name Brenner "A" #1  
Comp. Date 7-4-67 Old Total Depth 4059'

WATER SUPPLY INFORMATION

Disposition of Produced Water: Disposal  
Docket # Repressuring

WELL HISTORY

Drilling Method: X Mud Rotary Air Rotary Cable  
10-15-87 10-17-87 10-27-87  
Spud Date Date Reached TD Completion Date  
4060' 4031'  
Total Depth PBTD

Questions on this portion of the ACO-1 call:

Water Resources Board (913) 296-3717  
Source of Water:  
Division of Water Resources Permit #  
Groundwater...Ft North from Southeast Corner (Well) ...Ft West from Southeast Corner of Sec Twp Rge East West  
X Surface Water 990 Ft North from Southeast Corner (Stream, pond etc.) 3795 Ft West from Southeast Corner Sec 12 Twp 15S Rge 21 East X West  
Other (explain) (purchased from city, R.W.D. #)

Amount of Surface Pipe Set and Cemented at...feet  
Multiple Stage Cementing Collar Used? Yes X No  
If yes, show depth set...feet  
If alternate 2 completion, cement circulated from...feet depth to...w/...SX cmt  
Cement Company Name  
Invoice #


INSTRUCTIONS: This form shall be completed in triplicate and filed with the Kansas Corporation Commission, 200 Colorado Derby Building, Wichita, Kansas 67202, within 120 days of the spud date of any well. Rule 82-3-130, 82-3-107 and 82-3-106 apply. Information on side two of this form will be held confidential for a period of 12 months if requested in writing and submitted with the form. See rule 82-3-107 for confidentiality in excess of 12 months. One copy of all wireline logs and drillers time log shall be attached with this form. Submit CP-4 form with all plugged wells. Submit CP-111 form with all temporarily abandoned wells.

All requirements of the statutes, rules and regulations promulgated to regulate the oil and gas industry have been fully complied with and the statements herein are complete and correct to the best of my knowledge.

Signature John O. Farmer III  
John O. Farmer III  
Title Vice-president Date 10-28-87

K.C.C. OFFICE USE ONLY  
F Letter of Confidentiality Attached  
C Wireline Log Received  
C Drillers Timelog Received  
Distribution  
KCC SWD/Rap NGPA  
CORPORATION COMMISSION Plug Other (Specify)  
NOV 2 1987  
CONSERVATION DIVISION Wichita, Kansas Form ACO-1 (5-86)

Subscribed and sworn to before me this 28th day of October 1987  
Notary Public Margaret A. Schulte

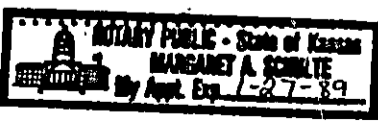

11-2-1987