


WELL PLUGGING RECORD

Give All Information Completely  
Make Required Affidavit  
Mail or Deliver Report to:  
Conservation Division  
State Corporation Commission  
800 Bitting Building  
Wichita, Kansas

Stafford County. Sec. 33 Twp. 21 Rge. (E) 12 (W)  
Location as "NE/CNW4SW4" or footage from lines SE NW NE  
Lease Owner Artnell Company  
Lease Name Sittner Well No. 4  
Office Address 101 Petroleum Bldg., Wichita, Kansas  
Character of Well (completed as Oil, Gas or Dry Hole) Oil Well  
Date well completed October 25, 19 46  
Application for plugging filed September 5, 19 56  
Application for plugging approved September 6, 19 56  
Plugging commenced September 10, 19 56  
Plugging completed September 12, 19 56  
Reason for abandonment of well or producing formation Economic limit.

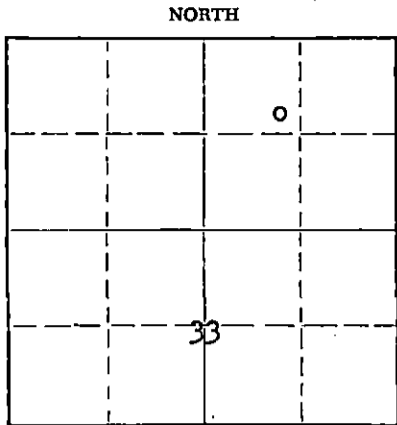

Locate well correctly on above  
Section Plat

If a producing well is abandoned, date of last production August 1, 19 56  
Was permission obtained from the Conservation Division or its agents before plugging was commenced? Yes

Name of Conservation Agent who supervised plugging of this well R. M. Brundage  
Producing formation Viola Depth to top 3517 Bottom 3540 Total Depth of Well 3624 Feet  
Show depth and thickness of all water, oil and gas formations.

OIL, GAS OR WATER RECORDS

CASING RECORD

FORMATION	CONTENT	FROM	TO	SIZE	PUT IN	PULLED OUT
Viola	Oil	3517	3540	5 1/2"	3606	2900
				10"	320	None

Describe in detail the manner in which the well was plugged, indicating where the mud fluid was placed and the method or methods used in introducing it into the hole. If cement or other plugs were used, state the character of same and depth placed, from \_\_\_\_\_ feet to \_\_\_\_\_ feet for each plug set.

3540 - 3510 Sand bridge  
3510 - 3480 Cement - 5 sacks  
3480 - 200 Heavy mud  
200 - 180 Rock bridge  
180 - 135 Cement - 50 sacks  
135 - 20 Mud  
20 - Cellar Cement - 15 Sacks

(If additional description is necessary, use BACK of this sheet)

Name of Plugging Contractor R & S Pipe Pulling Company  
Address Box 192, Ellinwood

STATE OF KANSAS, COUNTY OF SEDGWICK, ss.  
Walter W. Clements, Jr. (employee of owner) or (owner or operator) of the above-described well, being first duly sworn on oath, says: That I have knowledge of the facts, statements, and matters herein contained and the log of the above-described well as filed and that the same are true and correct. So help me God.

(Signature) [Signature]  
101 Petroleum Bldg., Wichita, Kansas  
(Address)

SUBSCRIBED AND SWORN TO before me this 13th day of November, 19 56

My commission expires \_\_\_\_\_  
Ruby Gourley Notary Public.

PLUGGING  
CONSERVATION DIVISION  
FILE SEC. 33 T. 21 R. (W) 12  
BOOK PAGE 96 LINE 43

RUBY GOURLEY  
My commission expires July 13, 1960

11-14-56

WELL LOG BUREAU KANSAS GEOLOGICAL SOCIETY  
 412 Union National Bk. Building  
 Wichita, Kansas

COMPANY: ARTNELL COMPANY Sec. 33 T. 21 R. 12-W  
 FARM: Sittner No. 4 SE/4 NW/4 NE/4

TOTAL DEPTH: 3624' COUNTY: Stafford,  
 COMM: 8-31-46 COMP: 10-9-46 Kansas  
 CONTRACTOR: Sterling Drilling Co.  
 ISSUED: 11-2-46 Rotary: 0 - 3607'  
 Cable : 3607 - 3624'

Casing:  
 10" 320' Cem. Elevation \_\_\_\_\_  
 5 1/2" 3606' Cem. Production: Pot. 15 B

Figures Indicate Bottom of Formations

Sand & Clay	100
Shale	325
Red bed	640
Anhydrite	665
Shale & Shells	900
Shale & Salt	1500
Lime & Shale	1560
Brkn lime	1655
Lime	1740
Shale & Shells	1800
Shale & Lime	2325
Lime	2360
Shale	2590
Shale & Shells	2700
Lime & Shale	2860
Lime	2965
Shale	3000
Lime	3175
Shale	3255
Lime	3550
Shale	3605
Lime	3607
T.D. W/Rot.	
Arbuckle Lime	3624
Total Depth	
Tops:	
Stone Corral (Anhydrite)	640-65
Topeka	2835
Heebner	3018-20
Base Oread	3168
Brown Lansing	3251
Lansing	3263
Base Kansas City	3500
Conglomerate	3500
Viola	3509
Simpson	3551
Arbuckle	3605

PLUGGING  
 FILE SEC 33 T. 21 R. 12W  
 BOOK PAGE 96 LINE 43

RECEIVED  
 CORPORATION COMMISSION  
 NOV 14 1946  
 ELEVATION DIVISION  
 Wichita, Kansas