

Give All Information Completely
Make Required Affidavit
Mail or Deliver Report to:
Conservation Division
State Corporation Commission
800 Bittling Building
Wichita, Kansas

WELL PLUGGING RECORD

NORTH

Locate well correctly on above
Section Plat

Barton County. Sec. 32 Twp. 16 Rge. 12 (X) (W)
Location as "NE/CNW $\frac{1}{4}$ SW $\frac{1}{4}$ " or footage from lines NE NW NW
Lease Owner Petroleum, Inc.
Lease Name Charles Well No. 1
Office Address 100 Derby Building, Wichita, Kansas
Character of Well (completed as Oil, Gas or Dry Hole) Dry Hole
Date well completed January 10, 19 51
Application for plugging filed January 10, 19 51
Application for plugging approved January 15, 19 51
Plugging commenced January 10, 19 51
Plugging completed January 10, 19 51
Reason for abandonment of well or producing formation Dry Hole

If a producing well is abandoned, date of last production 19
Was permission obtained from the Conservation Division or its agents before plugging was commenced? Yes

Name of Conservation Agent who supervised plugging of this well Mr. C. D. Stough
Producing formation Depth to top Bottom Total Depth of Well 3405 Feet
Show depth and thickness of all water, oil and gas formations.

OIL, GAS OR WATER RECORDS

CASING RECORD

Formation	Content	From	To	Size	Put In	Pulled Out
				8 5/8	271'	None

Describe in detail the manner in which the well was plugged, indicating where the mud fluid was placed and the method or methods used in introducing it into the hole. If cement or other plugs were used, state the character of same and depth placed, from feet to feet for each plug set.

Wooden plug set at 270'. Cemented and dis-
placed through drill pipe 15 sax. Filled
hole with heavy mud to 30'. Placed wooden plug
at 30'. Filled hole to surface with cement.

RECEIVED
STATE CORPORATION COMMISSION

JAN 18 1951

CONSERVATION DIVISION
Wichita, Kansas

(If additional description is necessary, use BACK of this sheet)

Correspondence regarding this well should be addressed to Petroleum, Inc.
Address 100 Derby Building, Wichita, Kansas


STATE OF KANSAS, COUNTY OF SEDGWICK, ss.
Eric H. Jager (employee of owner) of the above-described well,
being first duly sworn on oath, says: That I have knowledge of the facts, statements, and matters herein contained and the log of the above-described well as filed and that the same are true and correct. So help me God.

(Signature) Eric H. Jager
100 Derby Building, Wichita, Kansas
(Address)

SUBSCRIBED AND SWORN to before me this 17th day of January, 19 51

Charlotte Steedman
Notary Public.

My commission expires October 13, 1954

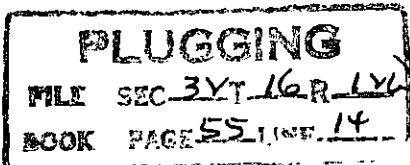

CHARLES WELL #1

Casing Record:-

8-5/8" Casing - 273.97'

Company - Petroleum, Inc.,
Contractor Aylward Drig. Co.Commenced - 12-26-50
Completed - 1-10-51

Description:-

NE 1/4 NW 1/4 of Section
32-16S-12W,
Barton Co., Kansas.Elevation
Production - D. & A.

<u>Formation</u>	<u>From</u>	<u>To</u>	<u>Remarks</u>
Surface Clay and Shale	0	271	Run 273.97' of 8-5/8" Casing and cemented w/ 150 sax.
Shale	271	400	
Shale and red bed	400	815	
Anhydrite	815	840	
Shale and Shells	840	1510	
Lime broken	1510	1620	
Lime	1620	1825	
Lime and shale	1825	1915	
Lime and shale	1915	1985	
Lime	1985	2075	
Lime and shale	2075	2300	
Shale and shells	2300	2500	
Lime and shale	2500	2600	
Shale	2600	2665	
Shale and lime	2665	2810	
Lime	2810	3055	
Lime and shale	3055	3113	
Lime	3113	3406	
		3406 - T.D.	

I certify that this is a true and correct copy of the above drillers log,
to the best of my knowledge.

Al Skalsky
Al Skalsky

Subscribed and sworn to before me this 15th day of January, 1951.

James Seth Huppert
Notary Public

My Commission Expires:

My commission expires Apr. 6, 1951

RECEIVED
STATE CORPORATION COMMISSION
JAN 18 1951
CONSERVATION DIVISION
Wichita, Kansas

PLUGGING
FILE SEC-3YT-16R-1YU
BOOK PAGE 55 LINE 14