


STATE OF KANSAS
STATE CORPORATION COMMISSION

Give All Information Completely
Make Required Affidavit
Mail or Deliver Report to:
Conservation Division
State Corporation Commission
800 Biting Building
Wichita, Kansas

15-009-06627-0000
WELL PLUGGING RECORD

Barton County, Sec. 25 Twp. 16 Rge. 12 (E) (W)
Location as "NE/CNW/SW" or footage from lines NE SE SW
Lease Owner C. D. Flournoy
Lease Name Oeser # 1 Well No. 1
Office Address Box 270 Hoisington, Kansas
Character of Well (completed as Oil, Gas or Dry Hole) Oil
Date well completed Sept, 4 19 52
Application for plugging filed Dec. 13 19 52
Application for plugging approved Dec. 13 19 52
Plugging commenced Dec. 14 19 52
Plugging completed Jan 10 19 53
Reason for abandonment of well or producing formation Dry Hole

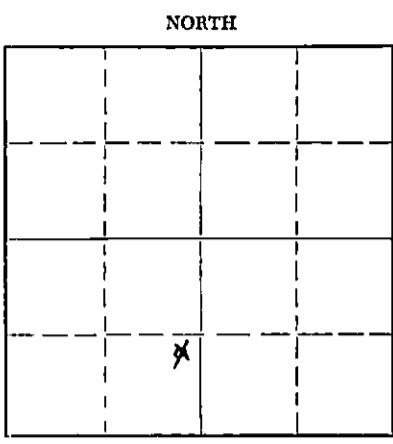

Locate well correctly on above Section Plat

If a producing well is abandoned, date of last production _____ 19____
Was permission obtained from the Conservation Division or its agents before plugging was commenced? Yes

Name of Conservation Agent who supervised plugging of this well C. D. Stough
Producing formation _____ Depth to top _____ Bottom _____ Total Depth of Well 3338 Feet
Show depth and thickness of all water, oil and gas formations.

OIL, GAS OR WATER RECORDS

CASING RECORD

FORMATION	CONTENT	FROM	TO	SIZE	PUT IN	PULLED OUT
				8-5/8"	147'	

Describe in detail the manner in which the well was plugged, indicating where the mud fluid was placed and the method or methods used in introducing it into the hole. If cement or other plugs were used, state the character of same and depth placed, from _____ feet to _____ feet for each plug set.

Well was plugged back from T. D. 3338 with crushed rock and 4 sacks cement. 4 1/2" casing set at 3330' - shot casing at 2186'. Pulled out casing, filled hole with heavy mud to bottom of surface pipe 147' - Set rock Bridge and dumped in 15 sacks cement with bailer - filled hole with heavy mud to 30' of bottom of cellar - Mixed 10 sacks for cap on well.

(If additional description is necessary, use BACK of this sheet)

Name of Plugging Contractor Flournoy-Haston Drlg Co., Inc.
Address Box 270 Hoisington, Kansas

STATE OF Kansas, COUNTY OF Barton, ss.

(employee of owner) or (owner or operator) of the above-described well, being first duly sworn on oath, says: That I have knowledge of the facts, statements, and matters herein contained and the log of the above-described well as filed and that the same are true and correct. So help me God.
(Signature) [Signature]
Hoisington, Kansas
(Address)

SUBSCRIBED AND SWORN TO before me this 19th day of January, 1953
Juanita P. [Signature]
STATE CORPORATION Notary Public!

My commission expires March 17, 1956

PLUGGING
FILE SEC 25 T 16 R 1234
BOOK PAGE 71 LINE 4

01-24-53 JAN 24 1953
CONSERVATION
Wichita, Kansas

Jan. 20, 1953

WELL LOG

Company-C. D. Flourney
Tools-Flourney*Haston Drlg. Co. Inc.

1 Oeser
NE SE SW of
Section 25-16-12.

Casing 8-5/8" 147' Cem. 100 sx.

FORMATION

Clay sand Shale	122'
Clay & Shale	147'
Shale & Shells	240'
Red Bed & Shale	350'
Sand & Shale	530'
Red Bed	780'
Anhydrite	815'
Shale & Shells	1365'
Shale & Lime	1615'
Lime	1870'
Lime & Shale	1965'
Shale & Lime Broken	2145'
Shale & Lime	2344'
Shale & Lime Broken	2559'
Shale & Lime	2730'
Lime	2985'
Lime & Sand	3031'
Sand Lime & Shale	3075'
Lime	3315'
Sand	3331'
Quartsite	3338'

T. D.

CERTIFICATION

I, C. D. Flourney, certify that the above is a true and correct copy of the drillers log of the above well.

RECEIVED
STATE CORPORATION COMMISSION
C. D. Flourney

JAN 24 1953
CONSERVATION DIVISION
Wichita, Kansas

PLUGGING
FILE SEC 25 T 16 R 12 W
BOOK PAGE 77 LINE 11