


STATE OF KANSAS  
STATE CORPORATION COMMISSION

Form CP-4

WELL PLUGGING RECORD

Give All Information Completely  
Make Required Affidavit  
Mail or Deliver Report to:  
Conservation Division  
State Corporation Commission  
212 No. Market  
Wichita, Kansas 67202

NORTH

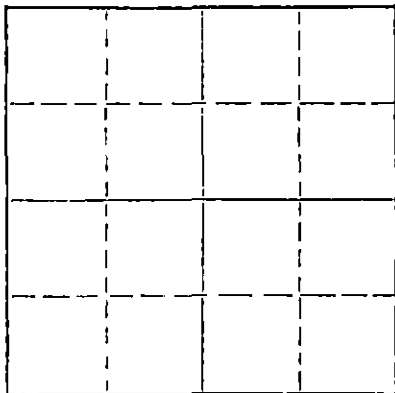

Locate well correctly on above  
Section Plat

Hodgeman County. Sec. 9 Twp. 21S Rge. (E) 24(W)

Location as "NE/CNW/SW" or footage from lines C NE NE

Lease Owner Thunderbird Drilling, Inc.

Lease Name Nelson Well No. "A" #1

Office Address 4328 E. Kellogg, Wichita, Kansas

Character of Well (completed as Oil, Gas or Dry Hole) Dry Hole

Date well completed 9-3 19 71

Application for plugging filed 9-3 19 71

Application for plugging approved 9-3 19 71

Plugging commenced 9-3 19 71

Plugging completed 9-4 19 71

Reason for abandonment of well or producing formation No oil or gas found in commercial quantities.

If a producing well is abandoned, date of last production --- 19 --

Was permission obtained from the Conservation Division or its agents before plugging was commenced? Yes

Name of Conservation Agent who supervised plugging of this well Edgar Eves

Producing formation \_\_\_\_\_ Depth to top \_\_\_\_\_ Bottom \_\_\_\_\_ Total Depth of Well 4400 Feet

Show depth and thickness of all water, oil and gas formations.

OIL, GAS OR WATER RECORDS

CASING RECORD

FORMATION	CONTENT	FROM	TO	SIZE	PUT IN	PULLED OUT
				8-5/8"	247'	-0-

Describe in detail the manner in which the well was plugged, indicating where the mud fluid was placed and the method or methods used in introducing it into the hole. If cement or other plugs were used, state the character of same and depth placed, from \_\_\_\_\_ feet to \_\_\_\_\_ feet for each plug set.

Set first plug at 850 feet with 80 sacks;

second plug at 247 feet with 30 sacks;

top plug at 45 feet with 15 sacks.

Plugging completed at 12:45 a.m. 9-4-71.

RECEIVED  
STATE CORPORATION COMMISSION  
SEP 10 1971  
CONSERVATION DIVISION  
Wichita, Kansas

(If additional description is necessary, use BACK of this sheet)

Name of Plugging Contractor Rains & Williamson Oil Co., Inc.

Address 435 Page Court, 220 West Douglas, Wichita, Kansas

STATE OF KANSAS, COUNTY OF SEDGWICK, ss.


Wilson Rains (employee of owner) or (owner or operator) of the above-described well, being first duly sworn on oath, says: That I have knowledge of the facts, statements, and matters herein contained and the log of the above-described well as filed and that the same are true and correct. So help me God.

(Signature) Wilson Rains Wilson Rains

435 Page Court, 220 W. Douglas, Wichita, Ks. (Address)

Subscribed and sworn to before me this 8 day of September, 19 71

Jeanine Durand  
Jeanine Durand Notary Public.

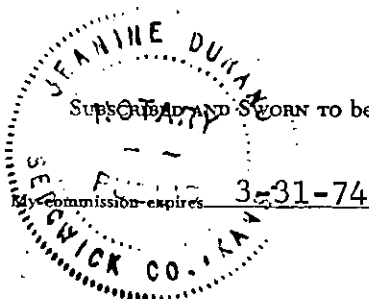

ROTARY DRILLING LOG

Operator: Thunderbird Drilling, Inc.  
 #1 NELSON "A"  
 C NE NE Section 9-21S-24W  
 Hodgeman County, Kansas

Contractor: Rains & Williamson  
 Oil Co., Inc.  
 Commenced: 8-26-71  
 Completed: 9-4-71  
 Casing: 8-5/8"/247'/150 sacks

Formations

Surface Clay and Post Rock	55'
Sand and Shale	150'
Sand, Shells and Shale	254'
Shale	970'
Sand	1165'
Shale and Red Bed	1230'
Shale and Shells	1487'
Anhydrite	1537'
Shale	1970'
Shale and Lime	2560'
Lime and Shale	3775'
Lime	4372'
Lime and Chert	4399'
Chert	4400'
Rotary Total Depth	4400'

RECEIVED  
 STATE CORPORATION COMMISSION  
 SEP 10 1971  
 CONSERVATION DIVISION  
 Wichita, Kansas

We certify the above log is true and correct, to the best of our knowledge and belief.

RAINS & WILLIAMSON OIL CO., INC.

*Wilson Rains*  
 \_\_\_\_\_  
 Wilson Rains

Subscribed and sworn to before me, a Notary Public within and for the State of Kansas, County of Sedgwick, this 8 day of September, 1971.

*Jeanine Durand*  
 \_\_\_\_\_  
 Jeanine Durand Notary Public



My Commission Expires: 3-31-74