


STATE OF KANSAS  
STATE CORPORATION COMMISSION

Form CP-4

WELL PLUGGING RECORD

Give All Information Completely  
Make Required Affidavit  
Mail or Deliver Report to:  
Conservation Division  
State Corporation Commission  
212 No. Market  
Wichita, Kansas

NORTH

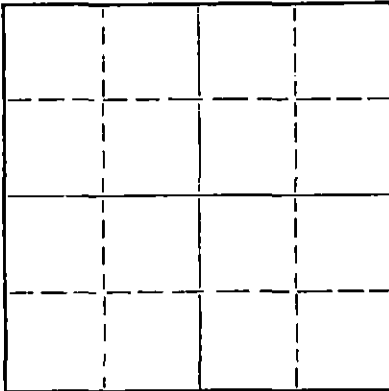

Locate well correctly on above  
Section Plat

Stafford County, Sec. 28 Twp. 21S Rge. (E) 12(W)  
Location as "NE/CNW/SW" or footage from lines NE NW NW  
Lease Owner Jay-Bee Oil Co.  
Lease Name GROW Well No. 1  
Office Address 515 511 Union Center, Wichita, Kansas  
Character of Well (completed as Oil, Gas or Dry Hole) Dry Hole  
Date well completed March 5, 1967  
Application for plugging filed 19  
Application for plugging approved 19  
Plugging commenced March 5, 1967  
Plugging completed March 5, 1967  
Reason for abandonment of well or producing formation Dry Hole

If a producing well is abandoned, date of last production 19  
Was permission obtained from the Conservation Division or its agents before plugging was commenced? Yes (Archie Elving)

Name of Conservation Agent who supervised plugging of this well  
Producing formation Depth to top Bottom Total Depth of Well 3678 Feet  
Show depth and thickness of all water, oil and gas formations.


OIL, GAS OR WATER RECORDS

CASING RECORD

FORMATION	CONTENT	FROM	TO	SIZE	PUT IN	PULLED OUT
	Surface	0	288'	8-5/8"	2/25/67	-----
	Casing					

Describe in detail the manner in which the well was plugged, indicating where the mud fluid was placed and the method or methods used in introducing it into the hole. If cement or other plugs were used, state the character of same and depth placed, from feet to feet for each plug set.

Heavy Mud from Total Depth to 280 feet;  
Hulls, Plug and 25 sax cement thru the  
drill pipe; Heavy Mud to 40 feet; Hull  
Plug, Plug bridged with Kelley and 10  
sax cement to base of cellar; 2 sacks  
cement in rat hole. Job completed at  
4:30 P.M. on 3/5/67.

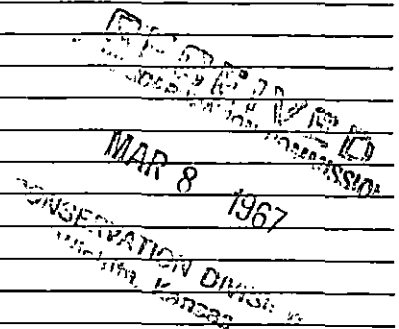

(If additional description is necessary, use BACK of this sheet)

Name of Plugging Contractor Sage Drilling Co.  
Address 500 Bitting Building, Wichita, Kansas

STATE OF KANSAS, COUNTY OF SEDGWICK, ss.  
Wayne W. Kahmeyer of Sage Drilling Co. (employee of owner) or (owner or operator) of the above described well, being first duly sworn on oath, says: That I have knowledge of the facts, statements, and matters herein contained and the log of the above-described well as filed and that the same are true and correct. So help me God.

(Signature) Wayne W. Kahmeyer  
500 Bitting Building, Wichita, Kansas  
(Address)

SUBSCRIBED AND SWORN to before me this 7th day of March, 1967

Louise K. Whitted  
Louise K. Whitted - Notary Public.

My commission expires November 26, 1970.

DRILLERS LOGGROW NO. 1

CASING RECORD:	COMPANY: Jay-Bee Oil Co.	DESCRIPTION:
8-5/8" @ 288' w/250 sax cement	CONTRACTOR: Sage Drilling Co.	NE NW NW Sec. 28-21S-12W Stafford County, Kansas
TOTAL DEPTH: 3678'	COMMENCED: February 25, 1967	COMPLETED: March 4, 1967

<u>FORMATION</u>	<u>FROM</u>	<u>TO</u>	<u>REMARKS</u>
Sand	0	185	
Clay & Sand	185	225	
Shale	225	288	
Red Bed	288	665	
Anhydrite	665	691	
Shale	691	1470	
Lime & Shale	1470	2190	
Shale	2190	2825	
Shale & Lime	2825	2853	
Lime & Shale	2853	3240	
Shale	3240	3271	
Lime & Shale	3271	3535	
Chert	3535	3556	
Shale	3556	3612	
Lime	3612	3678	

I certify that this is a true and correct copy of the above log to the best of my knowledge.

SAGE DRILLING CO., INC.

By Wayne W. Kahmeyer  
Wayne W. Kahmeyer

Subscribed and sworn to before me this 6th day of March, 1967.

Louise K. Whitted  
Louise K. Whitted, Notary Public

My commission expires:  
November 26, 1970.