

15.185.21080.0000


STATE OF KANSAS
STATE CORPORATION COMMISSION

WELL PLUGGING RECORD

Give All Information Completely.
Make Required Affidavit
Mail or Deliver Report to
Conservation Division
State Corporation Comm.
245 North Water
Wichita, KS 67202

Stafford County. Sec. 28 Twp. 21 Rge. 12 E/W
Location as "NE/CNW $\frac{1}{2}$ SW $\frac{1}{2}$ " or footage from lines

SE NW NW
Lease Owner Woodman & Iannitti Drilling Co.
Lease Name Grow Well No. 2
Office Address 1008 Douglas Bldg. 104 So. Broadway, Wichita, Kansas 67202
Character of Well (Completed as Oil, Gas or Dry Hole)

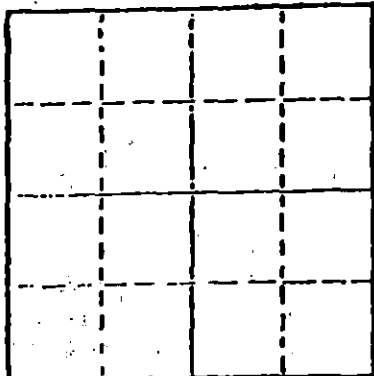

Locate well correctly on above Section Plat

dry hole
Date Well completed July 12 1980
Application for plugging filed July 12 1980
Application for plugging approved July 12 1980
Plugging commenced July 12 1980
Plugging completed July 12 1980
Reason for abandonment of well or producing formation

dry
If a producing well is abandoned, date of last production 19

Was permission obtained from the Conservation Division or its agents before plugging was commenced? yes

Name of Conservation Agent who supervised plugging of this well Wm. T. Owen
Producing formation Depth to top Bottom Total Depth of Well 3631'
Show depth and thickness of all water, oil and gas formations.

OIL, GAS OR WATER RECORDS

CASING RECORD

FORMATION	CONTENT	FROM	TO	SIZE	PUT IN	PULLED OUT
				8 5/8	293'	

Describe in detail the manner in which the well was plugged, indicating where the mud flu was placed and the method or methods used in introducing it into the hold. If cement or oth plugs were used, state the character of same and depth placed, from feet to feet for each plug set.

540' w/40 sx.
270' w/40 sx.
40' w/10 sx.

5 sx. in rathole

(If additional description is necessary, use BACK of this report)

Name of Plugging Contractor Woodman & Iannitti Drilling Co.

STATE OF KANSAS COUNTY OF SEDGWICK
K. T. Woodman (employee of owner) or owner or operat

of the above-described well, being first duly sworn on oath, says: That I have knowledge of the facts, statements, and matters herein contained and the log of the above-described well as filed and that the same are true and correct. So help me God.


(Signature)

1008 Douglas Bldg. Wichita, Kansas 67202
(Address)

SUBSCRIBED AND SWORN TO before me this 17th day of July, 19 80

My commission expires Feb. 11, 1984

Justina Chamberlain Notary Public.

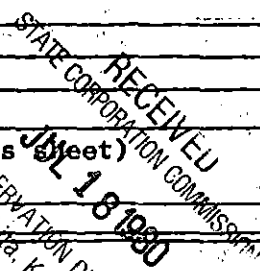

K. T. WOODMAN
 RES. PHONE 733-0418
 OFF. PHONE 265-7650
 WICHITA, KANSAS

D. J. IANNITTI
 PHONE 792-2921
 GREAT BEND, KANSAS

WOODMAN & IANNITTI DRILLING COMPANY
Rotary Drilling Contractors

1008 DOUGLAS BUILDING
 104 S. BROADWAY
 WICHITA, KANSAS 67202

July 17, 1980

Company;	Woodman & Iannitti Drilling Co.
Farm;	#2 Grow
Location;	SE NW NW
Section;	28-21-12W
County;	Stafford
Contractor;	Woodman & Iannitti Drilling Co.
Total Depth;	3631'
Comm;	July 7, 1980
Compl;	July 12, 1980
Casing;	8 5/8 @ 293 w/225 sx
Production;	D & A

Figures Indicate Bottom Of Formations;

15	Clay
40	Clay & sand
225	Sand
295	Shale
661	Redbed
683	Anhy
1500	Shale
1929	Shale & lime
2130	Lime
2580	Lime & shale
3145	Lime & shale
3185	Lime
3260	Shale
3395	Lime
3495	Lime & shale
3610	Lime
3631	Cong. & arbuckle

I certify the above to be a true and correct copy of the drillers log to the best of my knowledge and belief.

Woodman & Iannitti Drilling Co.

K. T. Woodman
 K. T. Woodman

STATE RECEIVED
 STATE CORPORATION COMMISSION
 JUL 18 1980
 CONSERVATION DIVISION
 Wichita, Kansas