


STATE OF KANSAS
STATE CORPORATION COMMISSION

WELL PLUGGING RECORD

Give All Information Completely
Make Required Affidavit
Mail or Deliver Report to:
Conservation Division
State Corporation Commission
800 Biring Building
Wichita, Kansas

Stafford County. Sec. 28 Twp. 21 Rge. 12 (E) (W)

Location as "NE/CNW/SW" or footage from lines SW SE NW
Lease Owner Petroleum, Inc.
Lease Name Grow 'A' Well No. 1
Office Address 305 East Third, Wichita 2, Kansas
Character of Well (completed as Oil, Gas or Dry Hole) Dry Hole
Date well completed August 14 19 53
Application for plugging filed August 14 19 53
Application for plugging approved August 14 19 53
Plugging commenced August 14 19 53
Plugging completed August 14 19 53
Reason for abandonment of well or producing formation Dry Hole

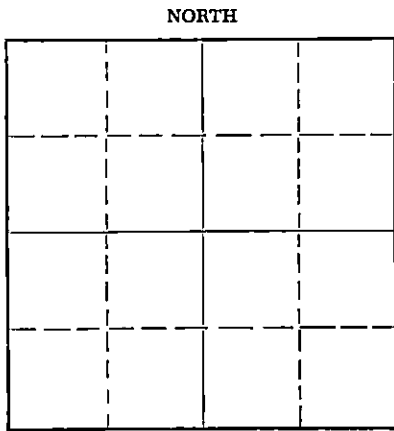

Locate well correctly on above Section Plat

If a producing well is abandoned, date of last production _____ 19____
Was permission obtained from the Conservation Division or its agents before plugging was commenced? Yes

Name of Conservation Agent who supervised plugging of this well Mr. M.A. Rives
Producing formation _____ Depth to top _____ Bottom _____ Total Depth of Well 3,619 Feet
Show depth and thickness of all water, oil and gas formations.

OIL, GAS OR WATER RECORDS

CASING RECORD

FORMATION	CONTENT	FROM	TO	SIZE	PUT IN	PULLED OUT
				8 5/8"	230'	None

Describe in detail the manner in which the well was plugged, indicating where the mud fluid was placed and the method or methods used in introducing it into the hole. If cement or other plugs were used, state the character of same and depth placed, from _____ feet to _____ feet for each plug set.

Mudded up to 210' and set wooden plug.

Placed 1/4 sack hull ahead of plug.

Cemented and displaced 20 sacks cement

through drill pipe onto plug at 210'.

Mudded up to 35' and set second wooden

plug. Filled hole to bottom of well

cellar with 10 sacks cement.

RECEIVED
STATE CORPORATION COMMISSION
AUG 29 1953
CONSERVATION DIVISION
Wichita, Kansas
8-29-1953

(If additional description is necessary, use BACK of this sheet)

Name of Plugging Contractor Garvey Drilling Company
Address R.R. #2, Great Bend, Kansas

STATE OF KANSAS, COUNTY OF SEDGWICK, ss.

(employee of owner) or (~~owner or operator~~) of the above-described well, being first duly sworn on oath, says: That I have knowledge of the facts, statements, and matters herein contained and the log of the above-described well as filed and that the same are true and correct. So help me God.

(Signature) W W Fisher
305 East Third, Wichita, Kansas
(Address)

SUBSCRIBED AND SWORN TO before me this 17th day of August, 19 53
Charlotte Heisman
Notary Public.

My commission expires October 13, 1954

PLUGGING
FILE SEC 28 T 21 R 12W
BOOK PAGE 122 LINE 6

DRILLER'S LOG GROW NO. 1

Petroleum, Inc., Operator

Section 28, Twp. 21S, Rge. 12W

Garvey Drilling Company, Contractor

Location: SW SE NW

Drilling Commenced: August 5, 1953

County: Stafford County, Kansas

Drilling Completed: August 14, 1953

Production: D & A

Casing Record: 8 5/8" @ 230' w/200 sax

Figures below indicate bottom of formation:

130	Surface & Sand
220	Sand
230	Shale
651	Red Bed
678	Anhydrite
1600	Shale & Shells
3295	Lime & Shale
3517	Lime
3564	Shale & Lime
3450	Lime
3595	Shale
3602	Shale
3619	Lime
3619	R.T.D.

Tops:

Heebner:	3128(-1272)
Brown Lime:	3261(-1405)
Lansing:	3273(-1417)
Arbuckle:	3602(-1746)

I hereby certify that this is a true and correct log of the above mentioned well.

PETROLEUM, INC.

BY W. W. Fisher

STATE CORPORATION COMMISSION
AUG 29 1953
CONSERVATION DIVISION
Wichita, Kansas

STATE OF KANSAS)
) SS:
COUNTY OF SEDGWICK)

Subscribed to and sworn to before me, a Notary Public, in said County and State, this 26th day of August, 1953.

Charlotte H. Kern
Notary Public

My commission expires: October 13, 1954

PLUGGING
FILE SEC 28 T 21 R 12W
BOOK PAGE 122 LINE 6