DISTRICT CONSERVATION AGENT'S REPORT

FILE NO.

TO:

Field


Total Depth 3629

State Corporation Commission Conservation Division 800 Bitting Building Wichita, Kansas

I have today completed supervision of plugging of:

Feet.

Well No. / Lease / Thousand

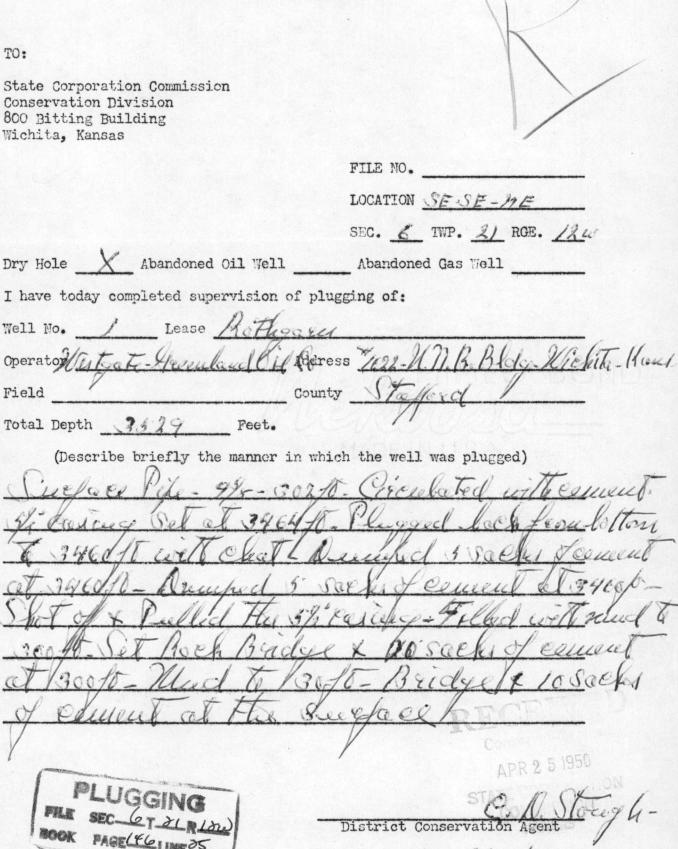



	STIO	not !
District	Conservation	Agent Tocay 4 -
Date	4-22-	50