

CONFIDENTIAL

COPY

15.111.20391.0000

CONFIDENTIAL

SIDE ONE

STATE CORPORATION COMMISSION OF KANSAS
OIL & GAS CONSERVATION DIVISION
WELL COMPLETION FORM
ACO-1 WELL HISTORY
DESCRIPTION OF WELL AND LEASE

API NO. 15- 111-20,381

County Lyon

NE NW SE Sec. 28 Twp. 21 Rge. 12 East West

2310 Ft. North from Southeast Corner of Section

1650 Ft. West from Southeast Corner of Section
(NOTE: Locate well in section plat below.)

Lease Name DUNCAN Well # 1

Field Name Wildcat

Producing Formation _____

Elevation: Ground 1233 KB 1239

Total Depth 2545 PBTD 2545

Operator: License # 5242

Name: Petroleum Management, Inc.

Address 14201 East Central

City/State/Zip Wichita, KS 67230

Purchaser: _____

Operator Contact Person: Steven P. O'Neill

Phone (316) 733-5600

Contractor: Name: Gaines Drilling

License: 5930


Wellsite Geologist: Tom Satter

STATE CORPORATION COMMISSION

Designate Type of Completion
 New Well Re-Entry Workover

Oil SWD Temp. Abd.
 Gas Inj Delayed Comp.
 Dry Other (Core, Water Supply, etc.)

RECEIVED
FEB 8 1991
CONSERVATION DIVISION
Wichita, Kansas
2-8-1991

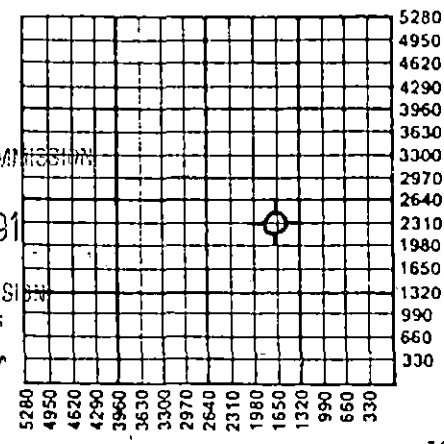

If **OWO**: old well info as follows:
Operator: _____

Well Name: _____

Comp. Date _____ Old Total Depth _____

Drilling Method:
 Mud Rotary Air Rotary Cable

1/25/91 2/2/91 2/3/91
Spud Date Date Reached TD Completion Date

Amount of Surface Pipe Set and Cemented at 101 Feet

Multiple Stage Cementing Collar Used? Yes No

If yes, show depth set _____ Feet

If Alternate II completion, cement circulated from _____

feet depth to _____ w/ _____ sx cmt.

INSTRUCTIONS: This form shall be completed in triplicate and filed with the Kansas Corporation Commission, 200 Colorado Derby Building, Wichita, Kansas 67202, within 120 days of the spud date of any well. Rule 82-3-130, 82-3-107 and 82-3-106 apply. Information on side two of this form will be held confidential for a period of 12 months if requested in writing and submitted with the form. See rule 82-3-107 for confidentiality in excess of 12 months. One copy of all wireline logs and drillers time log shall be attached with this form. ALL CEMENTING TICKETS MUST BE ATTACHED. Submit CP-4 form with all plugged wells. Submit CP-111 form with all temporarily abandoned wells. Any recompletion, workover or conversion of a well requires filing of ACO-2 within 120 days from commencement date of such work.

All requirements of the statutes, rules and regulations promulgated to regulate the oil and gas industry have been fully complied with and the statements herein are complete and correct to the best of my knowledge.

Signature Steven P. O'Neill Steven P. O'Neill

Title Petroleum Engineer Date 2/7/91

Subscribed and sworn to before me this 7th day of February, 19 91.

Notary Public Kathleen L. Carter

Date Commission Expires _____

KATHLEEN L. CARTER
NOTARY PUBLIC
STATE OF KANSAS
MY APPT. EXPIRES 4-29-91

K.C.C. OFFICE USE ONLY
F Letter of Confidentiality Attached
C Wireline Log Received
C Drillers Timelog Received
Distribution
 KCC SWD/Rep NGPA
 KGS Plug Other
(Specify)