


STATE OF KANSAS  
STATE CORPORATION COMMISSION

Form CP-4

WELL PLUGGING RECORD

Give All Information Completely  
Make Required Affidavit  
Mail or Deliver Report to:  
Conservation Division  
State Corporation Commission  
212 No. Market  
Wichita, Kansas

Stafford County. Sec. 24 Twp. 21S Rge. 12 (W)  
Location as "NE/CNW/SW" or footage from lines E/2 W/2 NW/4  
Lease Owner Abercrombie Drilling, Inc.  
Lease Name Stevenson Well No. 1  
Office Address 801 Union Center, Wichita, Kansas  
Character of Well (completed as Oil, Gas or Dry Hole) Dry Hole  
Date well completed February 17, 19 67  
Application for plugging filed (Verbally) February 17, 19 67  
Application for plugging approved (Verbally) February 17, 19 67  
Plugging commenced February 17, 19 67  
Plugging completed February 17, 19 67  
Reason for abandonment of well or producing formation Dry Hole

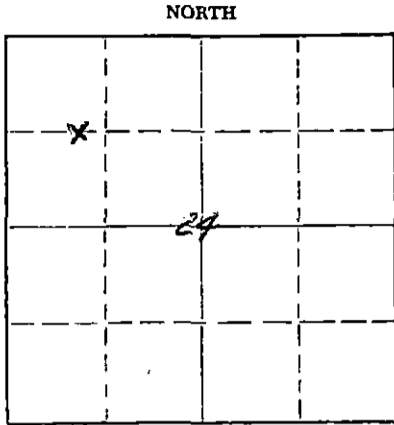

Locate well correctly on above  
Section Plat

If a producing well is abandoned, date of last production 19  
Was permission obtained from the Conservation Division or its agents before plugging was commenced? (Verbally) Yes

Name of Conservation Agent who supervised plugging of this well Archie Elving  
Producing formation \_\_\_\_\_ Depth to top \_\_\_\_\_ Bottom \_\_\_\_\_ Total Depth of Well 3640 Feet  
Show depth and thickness of all water, oil and gas formations.

OIL, GAS OR WATER RECORDS

CASING RECORD

FORMATION	CONTENT	FROM	TO	SIZE	PUT IN	PULLED OUT
				8-5/8"	260'	None

Describe in detail the manner in which the well was plugged, indicating where the mud fluid was placed and the method or methods used in introducing it into the hole. If cement or other plugs were used, state the character of same and depth placed, from \_\_\_\_\_ feet to \_\_\_\_\_ feet for each plug set.

First plug was set at 240' with 1/2 sack of hulls and 25 sacks of cement.  
Top plug was at 40' with 1/2 sack of hulls and 10 sacks of cement. Two sacks  
of cement were placed in the rat hole.

RECEIVED  
STATE CORPORATION COMMISSION

FEB 23 1967

CONSERVATION DIVISION  
Wichita, Kansas

7-23-1967

(If additional description is necessary, use BACK of this sheet)

Name of Plugging Contractor Abercrombie Drilling, Inc.  
Address 801 Union Center, Wichita, Kansas

STATE OF KANSAS, COUNTY OF SEDGWICK, SS.  
Jack K. Wharton (employee of owner) or (owner or operator) of the above-described well, being first duly sworn on oath, says: That I have knowledge of the facts, statements, and matters herein contained and the log of the above-described well as filed and that the same are true and correct. So help me God.

(Signature) Jack K. Wharton  
801 Union Center, Wichita, Kansas  
(Address)

SUBSCRIBED AND SWORN TO before me this 21st day of February, 19 67

My commission expires March 31, 1970

Margo Dee Montgomery  
Margo Dee Montgomery  
Notary Public.

CONTRACTOR'S WELL LOG

COMPANY: Abercrombie Drilling, Inc.  
 CONTRACTOR: Abercrombie Drilling, Inc.  
 FARM: STEVENSON #1  
 LOCATION: E/2 W/2 NW/4 of Sec. 24-21S-12W  
 Stafford County, Kansas  
 COMMENCED: February 8, 1967  
 COMPLETED: February 17, 1967

0	279	Surface, sand & clay
279	594	Shale
594	619	Anhydrite
619	1587	Shale & shells
1587	1825	Shale & lime
1825	1842	Flint
1842	1850	Shale
1850	2080	Shale with lime streaks
2080	2130	Lime & shale
2130	2808	Shale & lime
2808	3425	Lime & shale
3425	3490	Lime
3490	3550	Chert
3550	3575	Lime & shale
3575	3590	Lime
3590	3640	Lime & Shale
	3640	Total Depth

Set 8-5/8" surface at 260' with 250 sacks of Sunset cement.  
 Dry and Abandoned.

<u>FORMATION TOPS</u>		<u>ELEVATION:</u>	
Heebner	3080 (-1252)	1828 K.B.	
Toronto	3101 (-1273)	1827 D.F.	
Lansing	3208 (-1380)	1821 G.L.	
Conglomerate	3497 (-1669)		
Arbuckle	3634 (-1806)		
Total Depth	3640 (-1812)		


STATE OF KANSAS )  
 ) SS  
 COUNTY OF SEDGWICK )

I, Jack K. Wharton, do hereby certify that the above and foregoing is a true and correct copy of the log of the STEVENSON #1, E/2 W/2 NW/4 of Section 24-21S-12W, Stafford County, Kansas, as reflected by the files of Abercrombie Drilling, Inc.

*Jack K. Wharton*  
 Jack K. Wharton

Subscribed and sworn to before me, a Notary Public, in and for Sedgwick County, Kansas, this 21st day of February, 1967.

*Margo Dee Montgomery*  
 Margo Dee Montgomery, Notary

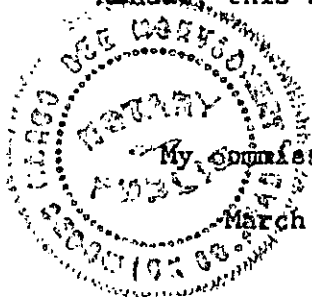

My Commission expires:  
 March 31, 1970

RECEIVED  
 STATE CORPORATION COMMISSION  
 FEB 23 1967  
 CONSERVATION DIVISION  
 Wichita, Kansas