


WELL PLUGGING RECORD

Give All Information Completely  
Make Required Affidavit  
Mail or Deliver Report to  
Conservation Division  
State Corporation Commission  
211 No. Broadway  
Wichita, Kansas

Stafford County, Sec. 24 Twp. 21S Rge. 12 (~~SE~~ W(W))  
Location as "NE/CNW/SW" or footage from lines SE SE NE  
Lease Owner JAY BERGMAN OIL COMPANY  
Lease Name Miller Well No. 1  
Office Address 425 Union Center, Wichita, Kansas  
Character of Well (completed as Oil, Gas or Dry Hole) Dry Hole  
Date well completed October 22 1959  
Application for plugging filed October 22, 1959  
Application for plugging approved October 22, 1959  
Plugging commenced October 22, 1959  
Plugging completed October 22, 1959  
Reason for abandonment of well or producing formation Dry Hole

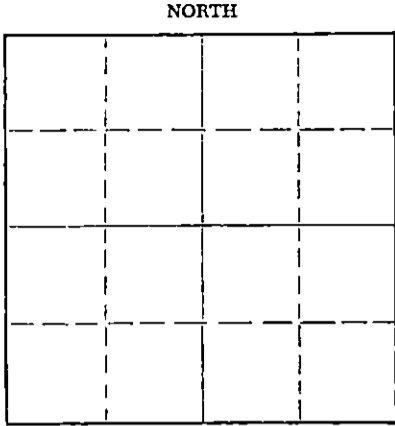

Locate well correctly on above Section Plat

If a producing well is abandoned, date of last production \_\_\_\_\_ 19\_\_\_\_  
Was permission obtained from the Conservation Division or its agents before plugging was commenced? Yes

Name of Conservation Agent who supervised plugging of this well Frank Broadfoot  
Producing formation none Depth to top \_\_\_\_\_ Bottom \_\_\_\_\_ Total Depth of Well 3650 Feet  
Show depth and thickness of all water, oil and gas formations.

OIL, GAS OR WATER RECORDS

CASING RECORD

FORMATION	CONTENT	FROM	TO	SIZE	PUT IN	PULLED OUT

Describe in detail the manner in which the well was plugged, indicating where the mud fluid was placed and the method or methods used in introducing it into the hole. If cement or other plugs were used, state the character of same and depth placed, from \_\_\_\_\_ feet to \_\_\_\_\_ feet for each plug set.  
8-5'8" - 365', circ. Fill hole with mud to 240', set plug with hulls, 20 sacks cement through drill pipe. Fill with mud to 35' set top plug with hulls. Capped with 10 sacks cement.

RECEIVED  
STATE CORPORATION COMMISSION  
OCT 29 1959  
CONSERVATION DIVISION  
WICHITA, KANSAS

(If additional description is necessary, use BACK of this sheet)  
Name of Plugging Contractor Bergman Drilling, Inc.  
Address 425 Union Center, Wichita, Kansas

STATE OF Sedgwi KANSAS, COUNTY OF SEDGWICK, ss.  
Harold Bergman (owner or operator) of the above-described well, being first duly sworn on oath, says: That I have knowledge of the facts, statements, and matters herein contained and the log of the above-described well as filed and that the same are true and correct. So help me God.

(Signature) Harold Bergman  
425 Union Center  
(Address) Wichita, Kansas 67209

SUBSCRIBED AND SWORN TO before me this 26th day of October, 1959  
Cecile L. Lawson  
Cecile L. Lawson Notary Public.

My commission expires June 30, 1963



WELL LOG

#1 Miller, SE SE NE, Sec. 24-T21s-R12w, Stafford County, Kansas

DATE STARTED: October 9, 1959

DATE COMPLETED: October 22, 1959

\* \* \* \* \*

0- 265 Sand, Red Bed Shale  
 265- 557 Surface Clay  
 557- 595 Anhydrite  
 595- 710 Shale & Shells  
 710-1350 Shale & Red Bed  
 1350-1450 Shale  
 1450-1585 Lime & Shale  
 1585-1785 Shale & Lime  
 1785-1945 Shale & Lime  
 1945-2115 Lime & Shale  
 2115-2275 Lime & Shale  
 2275-2380 Lime & Shale  
 2380-2595 Shale & Lime  
 2595-2780 Shale & Lime Shells  
 2780-2885 Lime Shale  
 2885-3000 Shale & Lime  
 3000-3090 Lime  
 3090-3190 Lime  
 3190-3265 Lime  
 3265-3315 Lime  
 3315-3353 Lime  
 3353-3412 Lime  
 3412-3461 Lime  
 3461-3506 Lime  
 3506-3544 Sand Shale  
 3544-3570 Arbuckle  
 3570-3588 Lime  
 3588-3600 Lime  
 3600-3650 Lime  
 3650 R. T. D.

GEOLOGICAL TOPS:

Elevation 1810 K. B.  
 Anhydrite 568(+1242)  
 Heebner Shale 3060 (-1250)  
 Brown Lime 3186 (-1376)  
 Lansing-Kansas City 3204 (-1394)  
 Base Kansas City 3445 (-1635)  
 Cherty Conglomerate 3479 (-1669)  
 Simpson Shale 3501 (-1691)  
 Simpson Sand 3519 (-1709)  
 Simpson Shale 3524 (-1714)  
 Arbuckle 3558 (-1748)  
 Rotary Total Depth 3650 (-1840)

RECEIVED  
 STATE CORPORATION COMMISSION  
 OCT 29 1959  
 CONSERVATION DIVISION  
 Wichita, Kansas

A F F I D A V I T

STATE OF KANSAS )  
 ) SS  
 COUNTY OF SEDGWICK )

I, do swear that the statements and matter herein contained are true to the best of my knowledge.

BERGMAN DRILLING, INC.

*Harold Bergman*  
 \_\_\_\_\_  
 Harold Bergman

Subscribed and sworn to before me this 28th day of October, 1959.

My commission expires: June 30, 1963

*Cecile L. Lawson*  
 \_\_\_\_\_  
 Cecile L. Lawson, Notary Public