

STATE OF KANSAS
STATE CORPORATION COMMISSION

Form CP-4

WELL PLUGGING RECORD

Give All Information Completely
Make Required Affidavit
Mail or Deliver Report to:
Conservation Division
State Corporation Commission
212 No. Market
Wichita, Kansas

Stafford

County. Sec. 6 Twp. 21 Rge. 12 (E) West (W)

Location as "NE/CNW&SW" or footage from lines CE/2 NE/4 SE/4

Lease Owner The Duke Drilling Company, Inc.

Lease Name LANTERMAN Well No. 2

Office Address Box 823 - Great Bend, Kansas

Character of Well (completed as Oil, Gas or Dry Hole) Dry Hole

Date well completed May 27 1968

Application for plugging filed May 27 1968

Application for plugging approved May 27 1968


Plugging commenced May 27 1968

Plugging completed May 27 1968

Reason for abandonment of well or producing formation _____

If a producing well is abandoned, date of last production _____ 19____

Was permission obtained from the Conservation Division or its agents before plugging was commenced? yes

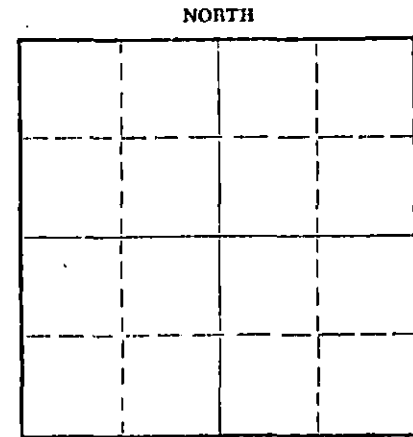

Locate well correctly on above Section Plat

Name of Conservation Agent who supervised plugging of this well Mr. Ralph Warren

Producing formation _____ Depth to top _____ Bottom _____ Total Depth of Well 3560 Feet

Show depth and thickness of all water, oil and gas formations.

OIL, GAS OR WATER RECORDS

CASING RECORD

FORMATION	CONTENT	FROM	TO	SIZE	PUT IN	PULLED OUT

Describe in detail the manner in which the well was plugged, indicating where the mud fluid was placed and the method or methods used in introducing it into the hole. If cement or other plugs were used, state the character of same and depth placed, from _____ feet to _____ feet for each plug set.

Filled hole with heavy mud to 280' with 1/2 sack hulls - set plug - 25 sacks cement

Filled hole with mud to 40' - 1/2 sack hulls - good bridge, 1/2 sack hulls - 10 sacks cement.

2 sacks cement in rat hole.

RECEIVED
STATE CORPORATION COMMISSION

JUN 3 1968

CONSERVATION DIVISION
Wichita, Kansas

(If additional description is necessary, use BACK of this sheet)

Name of Plugging Contractor _____

Address _____

STATE OF Kansas, COUNTY OF Barton, ss.

Larry Curtis (employee of owner) or (owner/processor) of the above-described well, being first duly sworn on oath, says: That I have knowledge of the facts, statements, and matters herein contained and the log of the above-described well as filed and that the same are true and correct. So help me God.

(Signature) Larry Curtis

Box 823 - Great Bend, Kansas

(Address)

SUBSCRIBED AND SWORN TO before me this 29 day of May, 1968

My commission expires April 11, 1970

Donothy M. Hague

Notary Public.

W E L L L O G

DATE COMMENCED: May 20, 1968
 DATE COMPLETED: May 27, 1968

Duke Drilling Company, Inc.
 LANTERMAN #2
 CE/2 NE/4 SE/4
 Sec. 6-21S-12W
 Stafford County, Kansas

0	-	225'	Sand
225	-	287'	Red Bed
287	-	299'	Sand & Shale
299	-	670'	Red Bed
670	-	686'	Anhydrite
686	-	1470'	Shale & Shells
1470	-	1520'	Lime & Shale
1520	-	2175'	Shale & Lime
2175	-	2740'	Lime w/Shale
2740	-	2891'	Some & Shale
2891	-	2990'	Lime Shaley
2990	-	3085'	Lime
3085	-	3105'	Lime & Shale
3105	-	3121'	Lime
3121	-	3214'	Shale
3214	-	3232'	Lime & Shale
3232	-	3442'	Lime
3442	-	3460'	Lime & Shale
3460	-	3477'	Shale & Chert
3477	-	3560'	Dolomite

ELEVATION: 1852 K.B.

FORMATION TOPS

Anhydrite	670
Heebner	3085
Toronto	3105
Douglas	3121
Lansing	3232
Conglomerate	3460
Arbuckle	3477
RTD	3560

Surface Casing: Set 8-5/8" used surface pipe at 287' with 225 sacks cement.

RECEIVED
 STATE CORPORATION COMMISSION
 JUN 3 1968
 CONSERVATION DIVISION
 Wichita, Kansas

A F F I D A V I T

STATE OF KANSAS
 COUNTY OF BARTON) ss.

Larry Curtis, of lawful age, does swear and state that the facts and statements herein contained are true and correct to the best of his knowledge.

Larry Curtis

Subscribed and sworn to before me this 31st day of MAY, 1968.

My Commission Expires:
April 11, 1970

Dorothy M. Hague
 Notary Public