

STATE OF KANSAS
STATE CORPORATION COMMISSION

Form CP-4

WELL PLUGGING RECORD

Give All Information Completely
Make Required Affidavit
Mail or Deliver Report to:
Conservation Division
State Corporation Commission
212 No. Market
Wichita, Kansas

Stafford County, Sec. 6 Twp. 21 Rge. (E) 12 (W)

Location as "NE/CNW/SW" or footage from lines SW NE NE

Lease Owner ROBINOWITZ OIL COMPANY

Lease Name TAMMEN Well No. 1

Office Address 1322 E. 50th., Tulsa, Oklahoma

Character of Well (completed as Oil, Gas or Dry Hole) Abandoned

Date well completed 4-28-66 19

Application for plugging filed 4-28-66 19

Application for plugging approved 4-28-66 19


Plugging commenced 5:00 P.M. 4-28-66 19

Plugging completed 7:00 P.M. 4-28-66 19

Reason for abandonment of well or producing formation Lost joint Surface
Pipe in Hole

If a producing well is abandoned, date of last production None 19

Was permission obtained from the Conservation Division or its agents before plugging was commenced? Yes

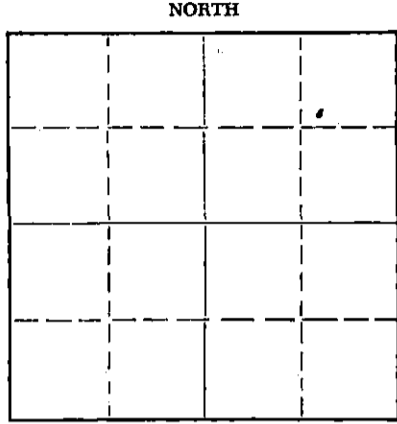

Locate well correctly on above
Section Plat

Name of Conservation Agent who supervised plugging of this well Archie Elving

Producing formation None Depth to top _____ Bottom _____ Total Depth of Well 1604' Feet

Show depth and thickness of all water, oil and gas formations.

OIL, GAS OR WATER RECORDS

CASING RECORD

FORMATION	CONTENT	FROM	TO	SIZE	PUT IN	PULLED OUT
Sand & Shale		0	207'	8 5/8"	205'	None

Describe in detail the manner in which the well was plugged, indicating where the mud fluid was placed and the method or methods used in introducing it into the hole. If cement or other plugs were used, state the character of same and depth placed, from _____ feet to _____ feet for each plug set.

Pushed Plug & 1/4 sack hulls to 200 ft. Mixed 25 sacks cement through drill pipe. Plug & 1/4 sack hulls to 40 ft. 10 sacks cement through drill pipe. 2 sacks cement in rat hole.

RECEIVED
STATE CORPORATION COMMISSION
MAY 3 - 1966
CONSERVATION DIVISION
WICHITA, KANSAS

(If additional description is necessary, use BACK of this sheet)

Name of Plugging Contractor B & B DRILLING, INC.
Address 548 Petroleum Bldg., Wichita, Kansas

STATE OF KANSAS COUNTY OF SEDGWICK, ss.

(employee of owner) or (owner or operator) of the above-described well, being first duly sworn on oath, says: That I have knowledge of the facts, statements, and matters herein contained and the log of the above-described well as filed and that the same are true and correct. So help me God.

(Signature) Bill Laker President

548 Petroleum Bldg. Wichita, Kansas
(Address)

SUBSCRIBED AND SWORN to before me this 2nd day of May, 19 66.

My commission expires January 12, 1970

Twyla Nadine Coleman
Notary Public.

B & B DRILLING, INC.

15.185.19512.0000

548 Petroleum Building
Wichita, Kansas 67202

May 2, 1966

DRILLERS LOG

Re: #1 Tammen
SW NE NE Sec. 6-21S-12W
Stafford County, Kansas

COMPANY: ROBINOWITZ OIL COMPANY
CONTRACTOR: B & B DRILLING, INC.
TOTAL DEPTH: 1604'
COMMENCED: April 27, 1966
COMPLETED: April 28, 1966

RECEIVED
STATE CORPORATION COMMISSION

MAY 3 - 1966

CONSERVATION DIVISION
WICHITA, KANSAS

0	205	Surface Hole
205	1320	Lime & Shale
1320	1604	Lime & Shale
	1605	Total Depth - Abandoned

We certify the Above and foregoing to be a true and correct copy of the log on the #1 Tammen, located in Stafford County, Kansas.

B & B DRILLING, INC.

Bill Baker
President

Subscribed and sworn to before me this 2nd day of May, 1966.

January 12, 1970

Theresa Nadine Coleman
Notary Public