


STATE OF KANSAS
STATE CORPORATION COMMISSION

Form CP-4

Give All Information Completely
Make Required Affidavit
Mail or Deliver Report to:
Conservation Division
State Corporation Commission
212 No. Market
Wichita, Kansas

WELL PLUGGING RECORD

NORTH

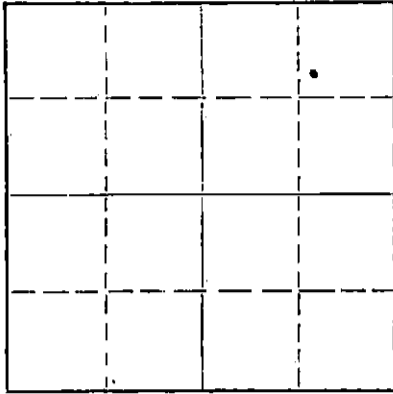

Locate well correctly on above
Section Plat

Stafford County. Sec. 6 Twp. 21S Rge. (E) 12 (W)
Location as "NE/CNW/SW" or footage from lines SW NE NE (60' to the East)
Lease Owner ROBINOWITZ OIL COMPANY
Lease Name TAMMEN Well No. 1
Office Address 1322 E. 50th., Tulsa, Oklahoma
Character of Well (completed as Oil, Gas or Dry Hole) Dry Hole
Date well completed May 6 1966
Application for plugging filed May 6 1966
Application for plugging approved May 6 1966
Plugging commenced May 6, 1966 12:30 P.M. 1966
Plugging completed May 6, 1966 2:00 P.M. 1966
Reason for abandonment of well or producing formation Dry Hole

If a producing well is abandoned, date of last production _____ 19____
Was permission obtained from the Conservation Division or its agents before plugging was commenced? Yes

Name of Conservation Agent who supervised plugging of this well Archie V. Elving
Producing formation None Depth to top _____ Bottom _____ Total Depth of Well 3492' Feet
Show depth and thickness of all water, oil and gas formations.

OIL, GAS OR WATER RECORDS

CASING RECORD

FORMATION	CONTENT	FROM	TO	SIZE	PUT IN	PULLED OUT
Sand & Shale		0	289'	8 5/8"	289'	None

Describe in detail the manner in which the well was plugged, indicating where the mud fluid was placed and the method or methods used in introducing it into the hole. If cement or other plugs were used, state the character of same and depth placed, from _____ feet to _____ feet for each plug set.

Hole filled up to 10' set plug & hulls in sk to 260' & cemented w/25 sacks through drill pipe. Fill hole to 40' bridged w/plug hulls & Cemented w/10 sacks cement through drill pipe. 2 sacks cement in rat hole

RECEIVED
STATE CORPORATION COMMISSION
MAY 10 1966
CONSERVATION DIVISION
Wichita, Kansas

(If additional description is necessary, use BACK of this sheet)

Name of Plugging Contractor B & B DRILLING, INC.
Address 548 Petroleum Bldg., Wichita, Kansas

STATE OF KANSAS COUNTY OF SEDGWICK, ss.
Bill Lahar

(employee of owner) or (owner or operator) of the above-described well, being first duly sworn on oath, says: That I have knowledge of the facts, statements, and matters herein contained and the log of the above-described well as filed and that the same are true and correct. So help me God.

(Signature) Bill Lahar President
548 Petroleum Bldg., Wichita, Kansas
(Address)

SUBSCRIBED AND SWORN TO before me this 9th day of May, 1966

My commission expires January 12, 1970

Twyla Nadine Coleman
Notary Public.

15.185.30241.0000

B & B DRILLING, INC.

548 Petroleum Building

Wichita, Kansas 67202

May 9, 1966

RECEIVED
STATE COMMISSION

MAY 10 1966

CONSERVATION DIVISION
Wichita, Kansas

DRILLERS LOG

Re: #1 Tammen
SW NE NE Sec.6-21S-12W(60' to E)
Stafford County, Kansas

COMPANY: ROBINOWITZ OIL COMPANY
CONTRACTOR: B & B DRILLING, INC.
TOTAL DEPTH: 3492'
COMMENCED: April 29, 1966
COMPLETED: May 6, 1966

0	289	Surface Hole
289	944	Redbed & Shale
944	1520	Shale
1520	1620	Lime & Shale
1620	2140	Lime & Shale
2140	2475	Shale & Lime
2475	2750	Lime & Shale
2750	2935	Lime & Shale
2935	3040	Lime & Shale
3040	3180	Lime
3180	3255	Lime & Shale
3255	3275	Lime
3275	3445	Lime
3445	3485	Lime
3485	3492	Lime Arb.
	3492	Total Depth

We certify the above and foregoing to be a true and correct copy of the log on the #1 Tammen, located in Stafford County, Kansas.

B & B DRILLING, INC.

Bill Sahar President

Subscribed and sworn to before me this 9th day of May, 1966

January 12, 1970

Thelma Madia Coleman
Notary Public