

STATE OF KANSAS
STATE CORPORATION COMMISSION

Give All Information Completely
Make Required Affidavit
Mail or Deliver Report to:
Conservation Division
State Corporation Commission
211 No. Broadway
Wichita, Kansas

WELL PLUGGING RECORD

Hodgeman County. Sec. 6 Twp. 21 Rge. (E) 24 (W)

Location as "NE/CNW/SW" or footage from lines SHNE

Lease Owner Sholom Drilling Company, Inc.

Lease Name MacNair Well No. 1

Office Address 6045 Pine Tree Drive, Miami Beach, Fla. 33140

Character of Well (completed as Oil, Gas or Dry Hole) Dry

Date well completed July 18, 1964

Application for plugging filed July 18, 1964

Application for plugging approved July 18, 1964


Plugging commenced July 18, 1964

Plugging completed 3 P.M. July 18, 1964

Reason for abandonment of well or producing formation Dry

If a producing well is abandoned, date of last production 19

Was permission obtained from the Conservation Division or its agents before plugging was commenced? Yes

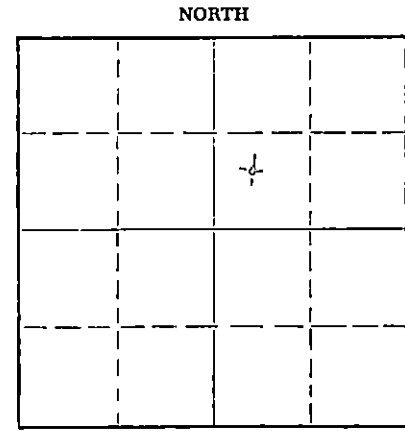

Locate well correctly on above Section Plat

Name of Conservation Agent who supervised plugging of this well Mr. Scott

Producing formation _____ Depth to top _____ Bottom _____ Total Depth of Well 4505 Feet

Show depth and thickness of all water, oil and gas formations.

OIL, GAS OR WATER RECORDS

CASING RECORD

FORMATION	CONTENT	FROM	TO	SIZE	PUT IN	PULLED OUT
Mississippi	Water	4478	4505	8 5/8	258	none

Describe in detail the manner in which the well was plugged, indicating where the mud fluid was placed and the method or methods used in introducing it into the hole. If cement or other plugs were used, state the character of same and depth placed, from _____ feet to _____ feet for each plug set.

Used Sun Cementing Truck: 25 sax cement plug @ 700'
mud to 250'
25 sax cement plug @ 250'
mud to 45'
15 sax cement and hulls plug @ 45'

RECEIVED
STATE CORPORATION COMMISSION

JUL 28 1964

CONSERVATION DIVISION
Wichita, Kansas

7-28-1964

(If additional description is necessary, use BACK of this sheet)

Name of Plugging Contractor Rotary Hole - Dry

Address _____

STATE OF FLORIDA, COUNTY OF DADE, ss.

I, Joseph Teichman (employee of owner) or (owner or operator) of the above-described well, being first duly sworn on oath, says: That I have knowledge of the facts, statements, and matters herein contained and the log of the above-described well as filed and that the same are true and correct. So help me God. SHOLOM DRILLING COMPANY, INC.

(Signature) BY: Joseph Teichman

6045 Pine Tree Drive, Miami Beach, Fla. 33140
(Address)

SUBSCRIBED AND SWORN TO before me this 23rd day of July, 19 64

NOTARY PUBLIC STATE OF FLORIDA at LARGE
MY COMMISSION EXPIRES JUNE 9, 1968
BONDED THROUGH FRED W. DIEBELHORST

Miriam Unger

Notary Public.

My commission expires _____

SHOLOM DRILLING COMPANY, INC.
6045 Pine Tree Drive
Miami Beach, Florida 33140

COMPANY: SHOLOM DRILLING COMPANY, INC.
FARM: #1 MacNair
LOCATION: SWNE Sec 6 - 21S - 24W, Hodgeman County, Kansas
ROTARY DRILLING CONTRACTOR: Sholom Drilling Co., Inc.

COMMENCED: 7/6/64
COMPLETED: 7/18/64 w/Rotary Tools Rotary T.D. 4505'
I.P. : D. & A

Casing Record:
8 5/8 @ 256' w/160 sax

L O G

0 - 80 Clay & Post Rock
80 - 720 Shale
720 - 928 Red Bed
928 - 978 Anhydrite
978 - 1050 Red bed, shale & shells
1050 - 1260 Sand
1260 - 1578 Red bed & shale
1578 - 1619 Anhydrite
1619 - 3702 Shale & lime
3702 - 4445 Lime
4445 - 4460 Chert
4460 - 4490 Chert & lime
4490 - 4505 Chert & dolomite
4505 T.D.

Drill Stem Test

#1 - 4236-4325 Rec. 150' mud, 380'
salt water, 20" ICIP 400'
FCIP# = P 0#

RECEIVED
STATE CORPORATION COMMISSION

JUL 28 1964

CONSERVATION DIVISION
Wichita, Kansas

STATE OF FLORIDA)
) ss.
COUNTY OF DADE)

I, Joseph Teichman, President of Sholom Drilling Company, Inc.,
a corporation of the State of Oklahoma, domesticated in the State of
Kansas, being first duly sworn under oath, says: That I have
knowledge of the facts, statements, and matters herein contained of
the above described well as filed and that the same are true and
correct.

Joseph Teichman

Joseph Teichman

Subscribed and sworn to before me this 23rd day of July, 1964

Miriam Wenger

Notary Public